


6-9761
67570

T. 36S., R. 12E., W.M.

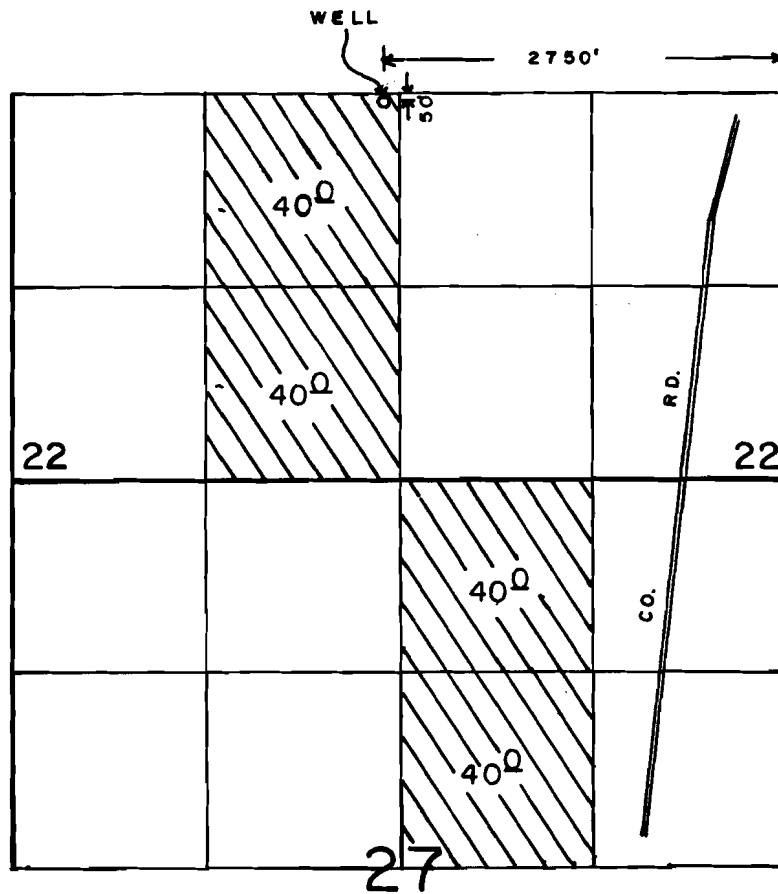

SCALE: 1" = 1320'

**FINAL PROOF SURVEY
UNDER**

Application No. G-10665 Permit No. G-9761....
IN NAME OF

.....EARL K. ALLISON.....

Surveyed JULY 9, 1991, by B.W. BISHOP....

