


T. 1N., R. 13E., W.M.

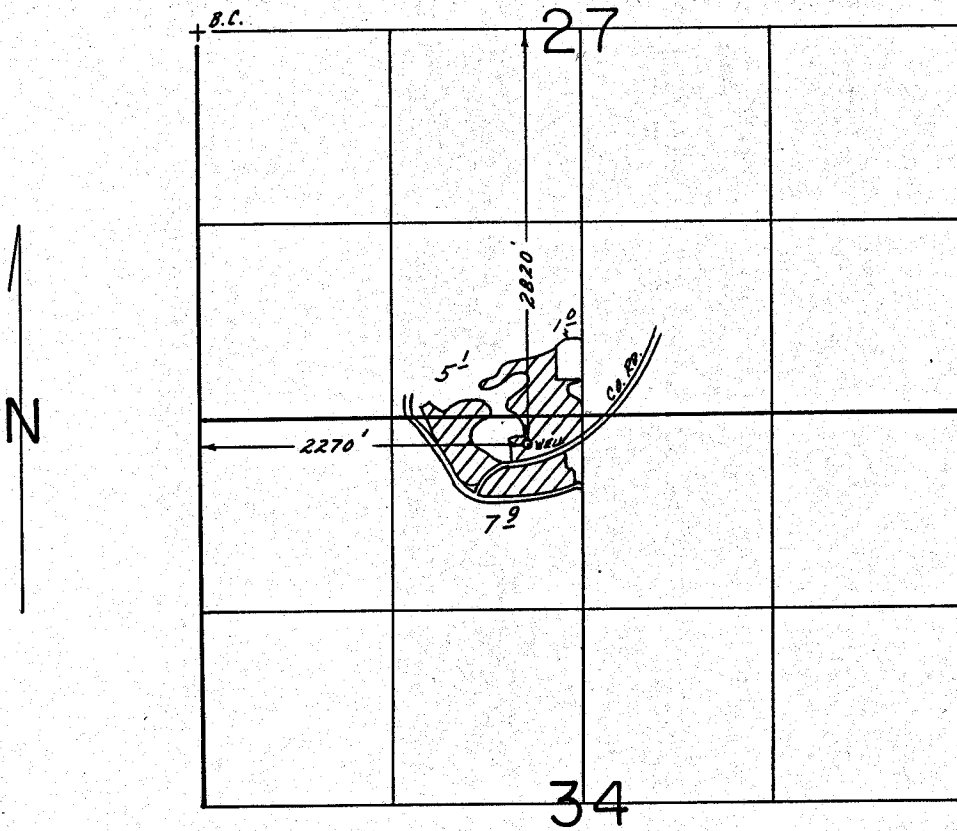

SCALE: 1" = 1320'

FINAL PROOF SURVEY
UNDER

Application No. G-10667. Permit No. G-9762....
IN NAME OF

ALBIN RASZLER

Surveyed June 7, 1988, by T.M. WARREN

5/5/89
GWB
41065-179-135L