


# T.36S.,R.IIE.,W.M.

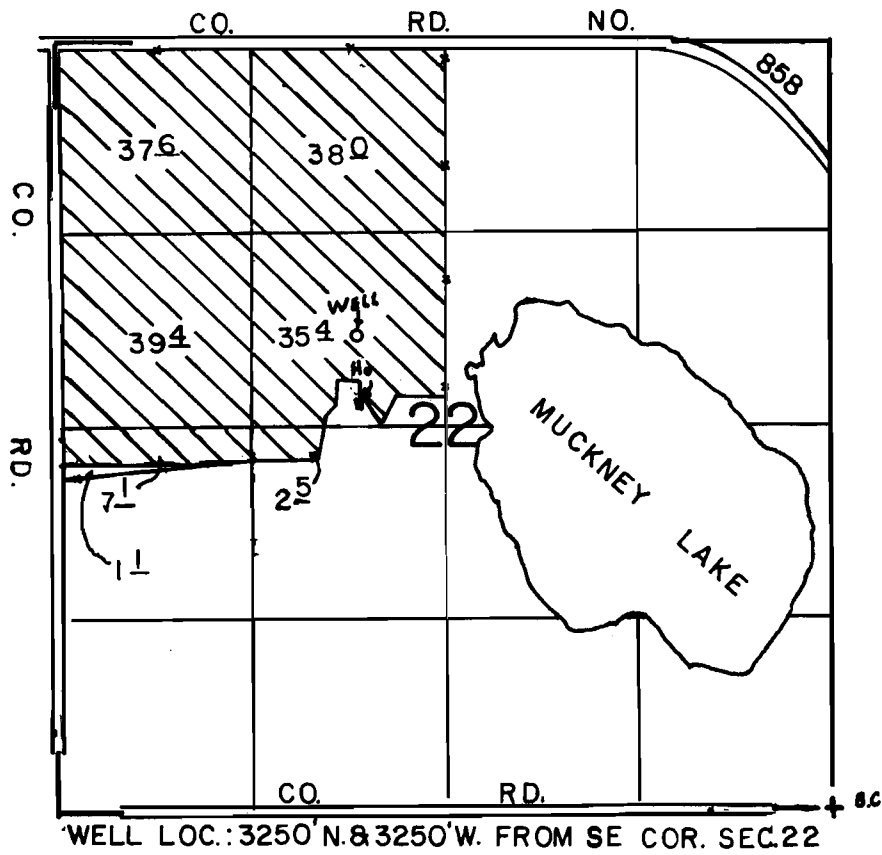

SCALE: 1" = 1320'

## FINAL PROOF SURVEY UNDER

Application No. G-10724 Permit No. G-9987  
IN NAME OF

.....BILLY T. COLLEY.....

Surveyed JUNE 5. 1991., by B.W. BISHOP...

*Monique Green Wells*