




T. 39 S., R. 8 E., W.M.

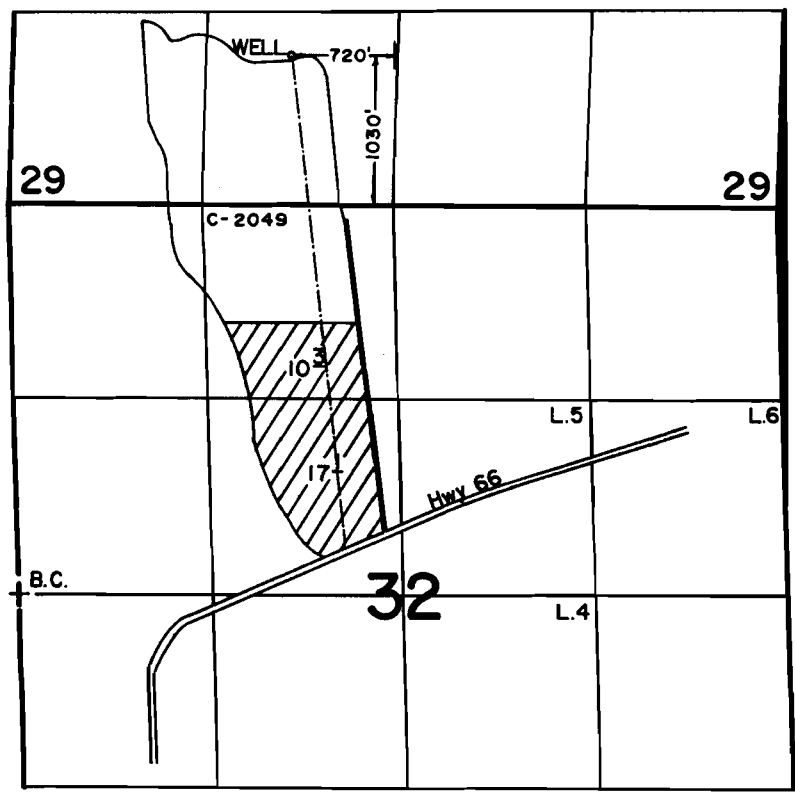

Klamath River Wells

SCALE: 1" = 1320'

FINAL PROOF SURVEY UNDER

Application No. ~~G-10749~~ Permit No. G-10354
IN NAME OF

SCOTT JOHNSTON, GWEN JOHNSTON & DON JOHNSTON

Surveyed JUNE 14, 1989, by B.W. BISHOP.....