


T. 3 S. R. 16 E. W.M.

↑
N

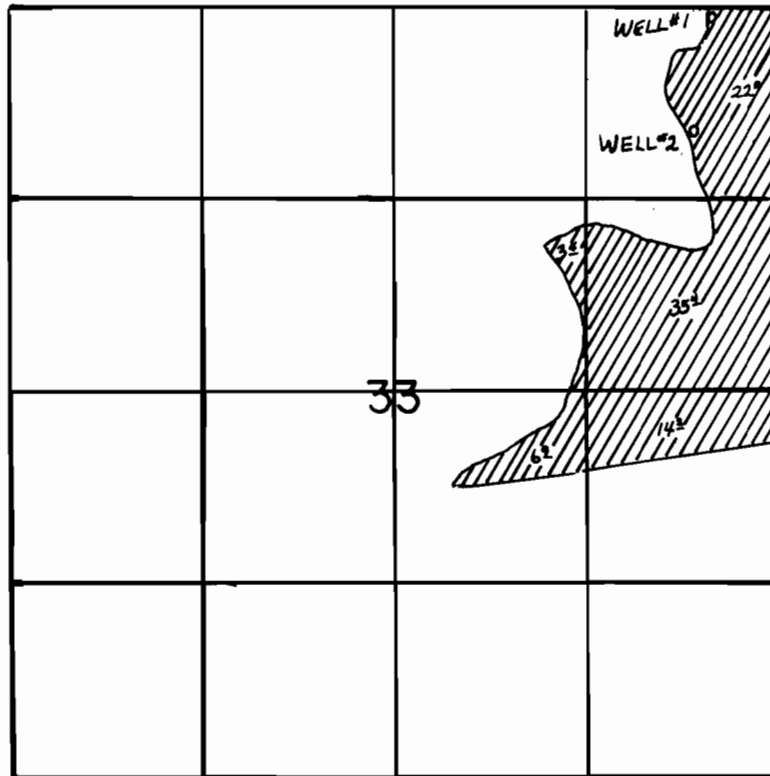

WELL #1 - 60' S. and 460' W.; WELL #2 - 840' S. and 590' W., both from the NE Corner of S. 33, being within the NE $\frac{1}{4}$ NE $\frac{1}{4}$ of S.33, T.3 S. R 16 E., WM.

FINAL PROOF SURVEY UNDER

Application No. ~~G-10879~~ Permit No. G10074..
IN NAME OF

.....FRED. A. JUSTESEN.....

Surveyed ~~10-8~~ 1991., by J. Miller.....

41055-279-134L
NCR
Jm 1-22-92