


T. 3 S. R. 16 E. W.M.

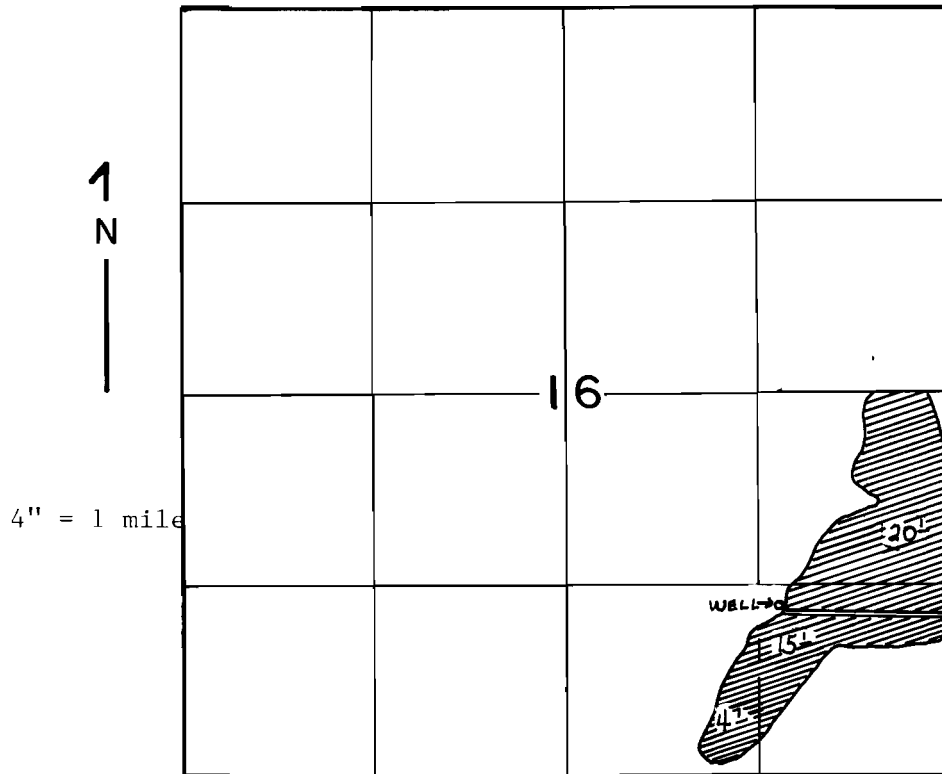

WELL is located 1130' N. and 1180' W. from the
SE Corner of Section 16. being within $SE\frac{1}{4}$ $SE\frac{1}{4}$ of
Section 16, T. 3 S., R 16 E., W.M.

FINAL PROOF SURVEY
UNDER

Application No. ~~G-10880~~ Permit No. ~~G-10075~~
IN NAME OF

FRED. A. JUSTESEN

Surveyed 10-9 1991, by J. MILLER

41055-279-134L

MCR

gm 1-22-92