


T.13 S. R.32 E. W.M.

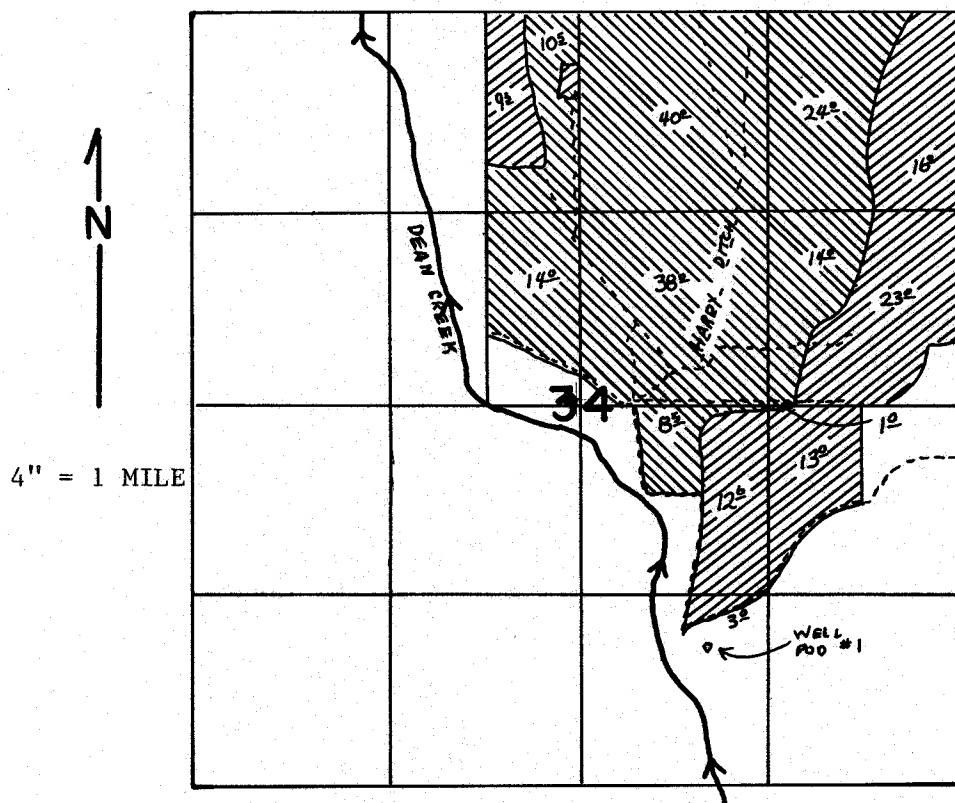

Diversion#1 1650'S and 1740'W from E $\frac{1}{4}$ corner
Sec. 34 T.13 S. R.32 E. WM.



PRIMARY



SUPPLEMENTAL

FINAL PROOF SURVEY

Application No. **G-1508** Permit No. **G10601**
IN NAME OF

.....ROBERT HEIPLE.....

Surveyed 11-13 1991, by J.MILLER.....

41023-279-57D
NCR
gm 1-22-92