
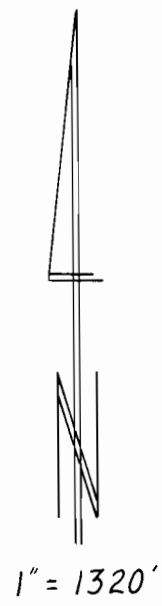


T 8 S R I W W M

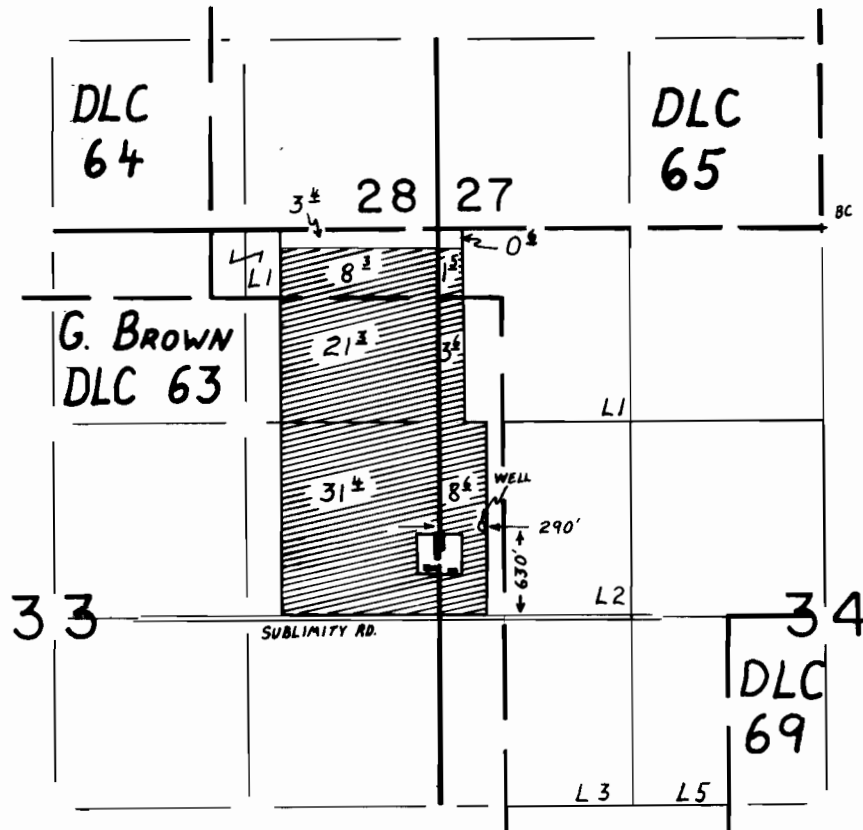

FINAL PROOF SURVEY UNDER

Application No. G-11650. Permit No. G-10726.

IN NAME OF

LAWRENCE A. FRANK

Surveyed FEB. 20, 1991, by H. KEMP