


THE PREPARATION OF THIS MAP WAS FOR THE PURPOSE OF IDENTIFYING THE WATER RIGHT ONLY & HAS NO INTENT TO PROVIDE DIMENSION OR LOCATION OF PROPERTY OWNERSHIP LINES.

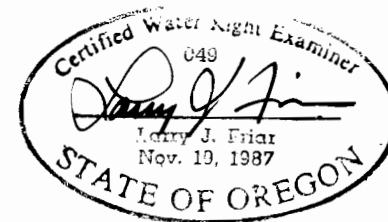

FINAL PROOF MAP
 UNDER
 APPLICATION NO. G11808, PERMIT NO. G10809
 IN THE NAME OF
 JAMES C. MILLER

NOV. 20, 1991 SCALE: 1" = 1320'
 PREPARED BY: LARRY J. FRIAR
 L.J. FRIAR & ASSOCIATES
 304 S. HOLLY ST.
 MEDFORD, OREGON