


T. 1 S., R. 3 W., W.M.

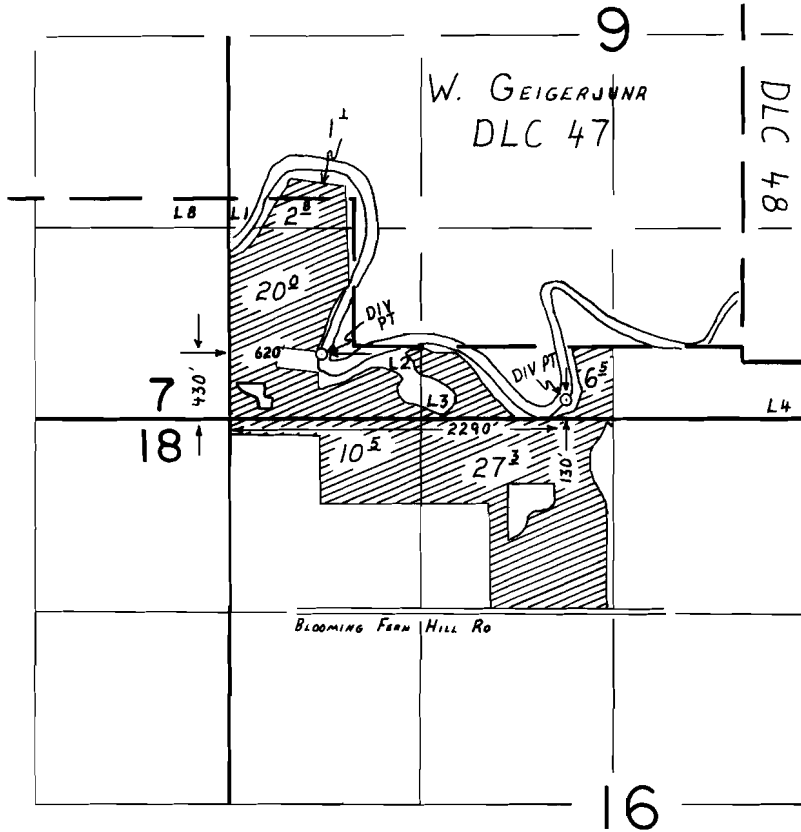

FINAL PROOF SURVEY

UNDER

Application No. 44533 Permit No. 33059

IN NAME OF

GEORGE GOFF

Surveyed JULY 25, 1986, by B.W. BISHOP