
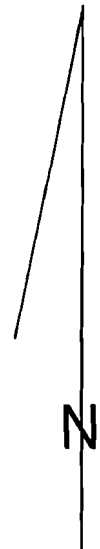


T.36S.,R12E.,W.M.

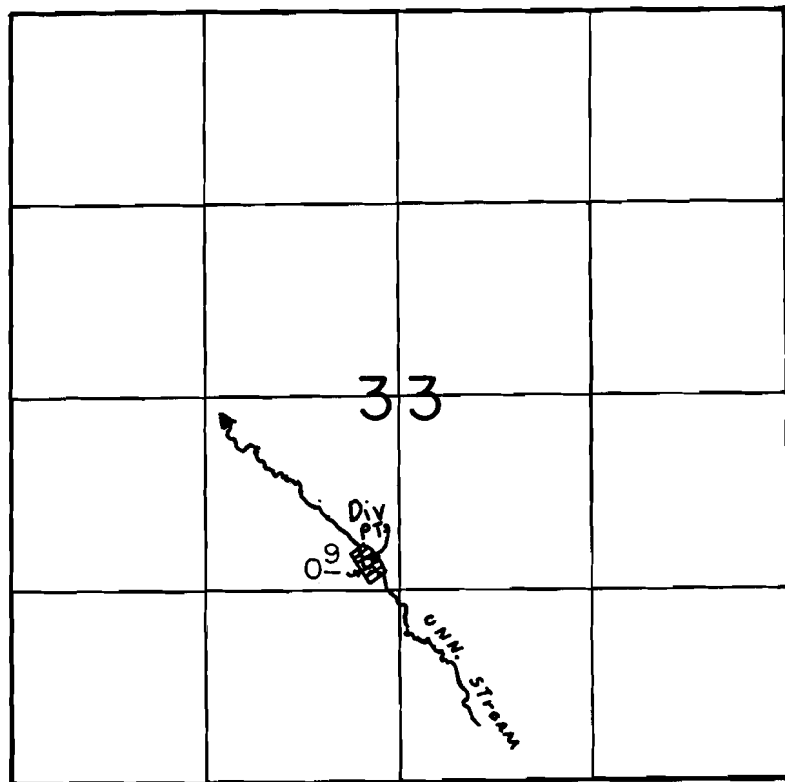

DIV.PT.LOC.: 1500' N. 2870' W. FROM SE COR. OF SEC. 33.

SCALE: 1" = 1320'

FINAL PROOF SURVEY **UNDER**

Application No. 50343 Permit No. 38005.....
IN NAME OF

.....SAMUEL R. & DONNA ELAM.....

Surveyed MAY 1... 1991.., by B.W. BISHOP..

Whiskey Creek Misc.