


T. 13 S., R. 6 W., W.M.

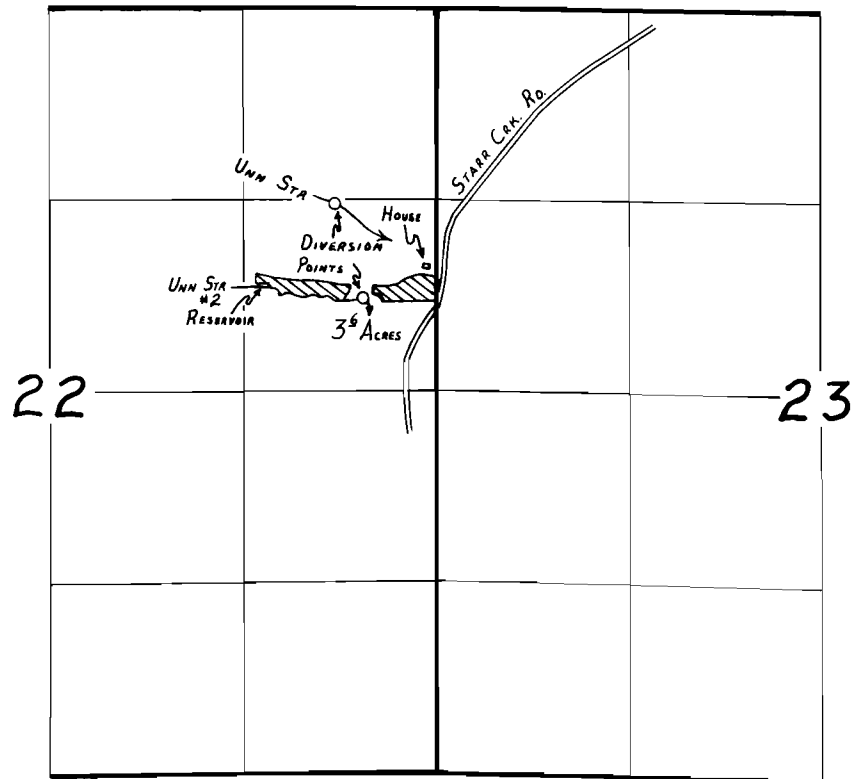

DIVERSION FROM UNN STREAM LOCATED: 1280' N & 700' W
DIVERSION FROM UNN STREAM # 2 LOCATED: 630' N & 500' W
DAM LOCATED: 730' N & 1140' W
ALL BEING LOCATED FROM THE E 1/4 CORNER SECTION 22

FINAL PROOF SURVEY

UNDER

Application No. R-50578 & 50579 Permit No. R-6165 & 38184
IN NAME OF

LARRY WINIARSKI

Surveyed MARCH 8, 1991, by R.W. KLASSEN