


T. 338 & 34 S., R. 7 1/2 E., W.M.

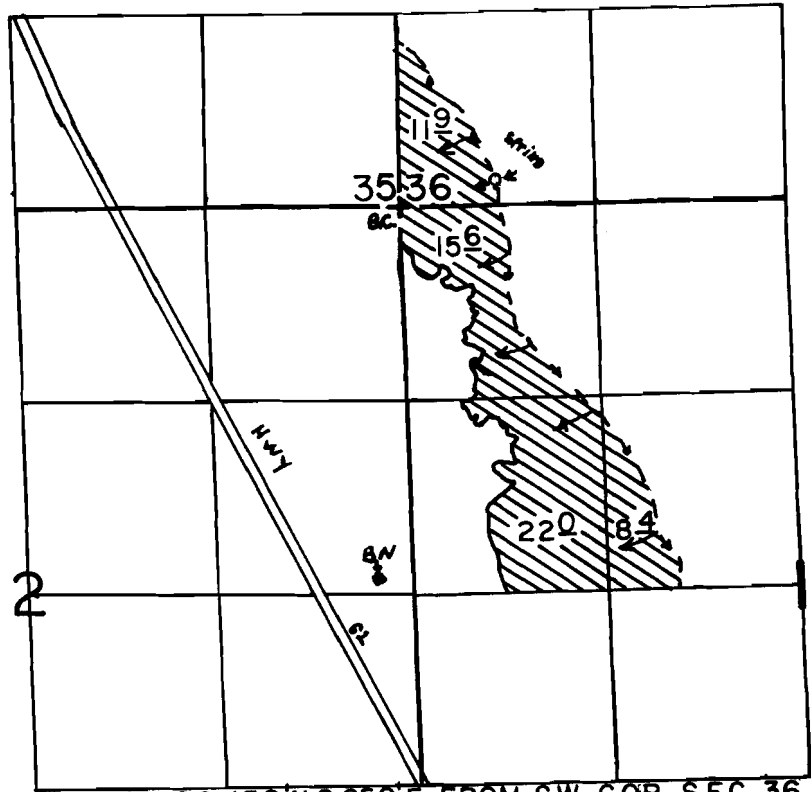

SPRING LOC: 150' N & 650' E FROM SW COR. SEC. 36.

SCALE: 1" = 1320'

FINAL PROOF SURVEY UNDER

Application No. 51098. Permit No. 37419.....
IN NAME OF

...JOHN...B.&...KENNETH...H...R...OWENS

Surveyed SEPT. 3. 19.91., by ..B.W..BISHOP.

Crooked Creek & Mill