


T. 33 S., R. 15 W., W.M.

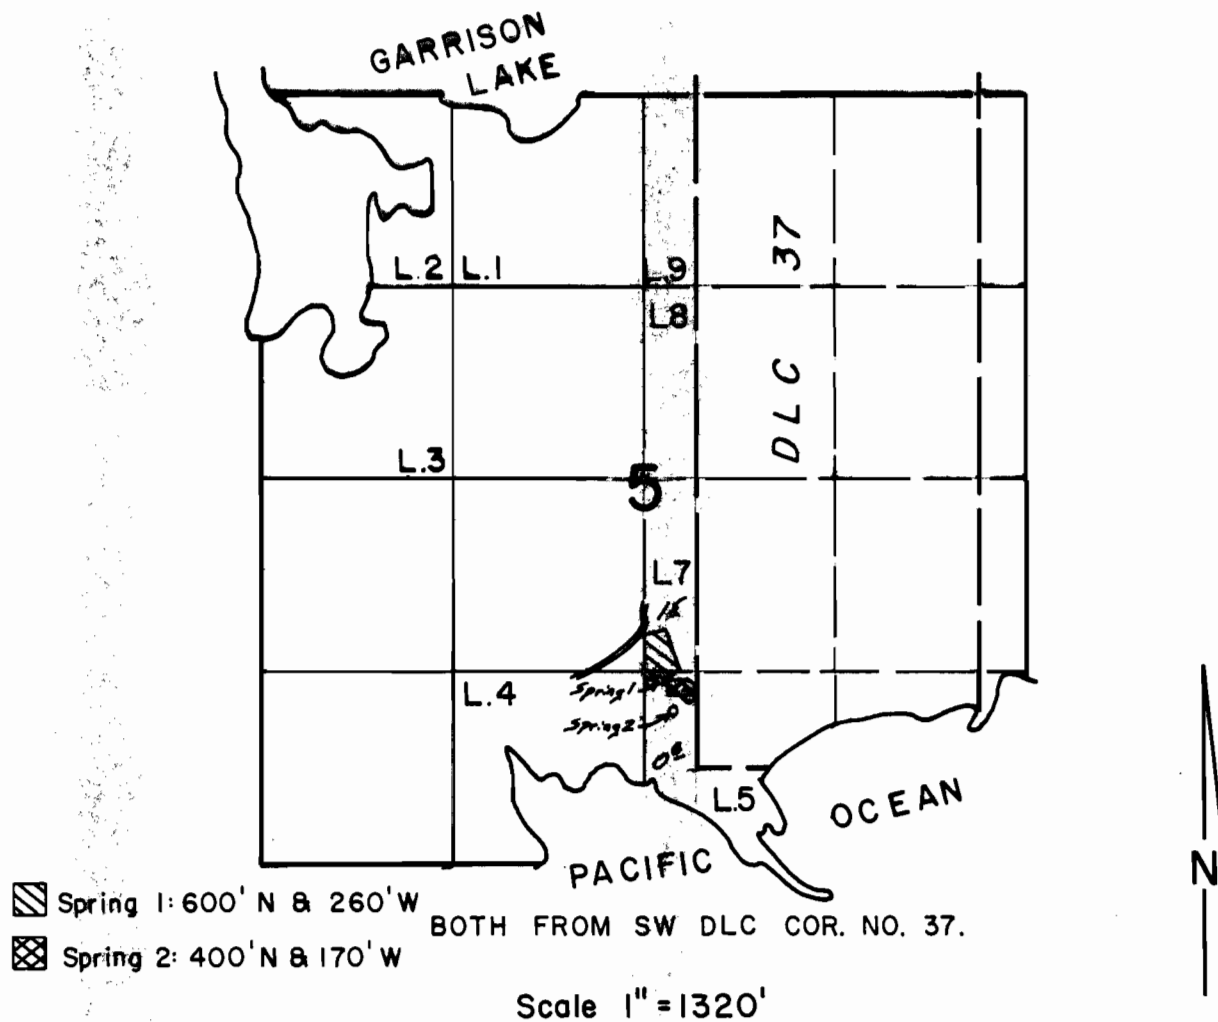

FINAL PROOF SURVEY
UNDER

Application No. 57163 Permit No. 43124.....
IN NAME OF

JAMES W. & EFFIE P. PARSONS

Surveyed Sep 24 1991., by B.S. JAMES