


T.34S.,R.7E.,W.M.

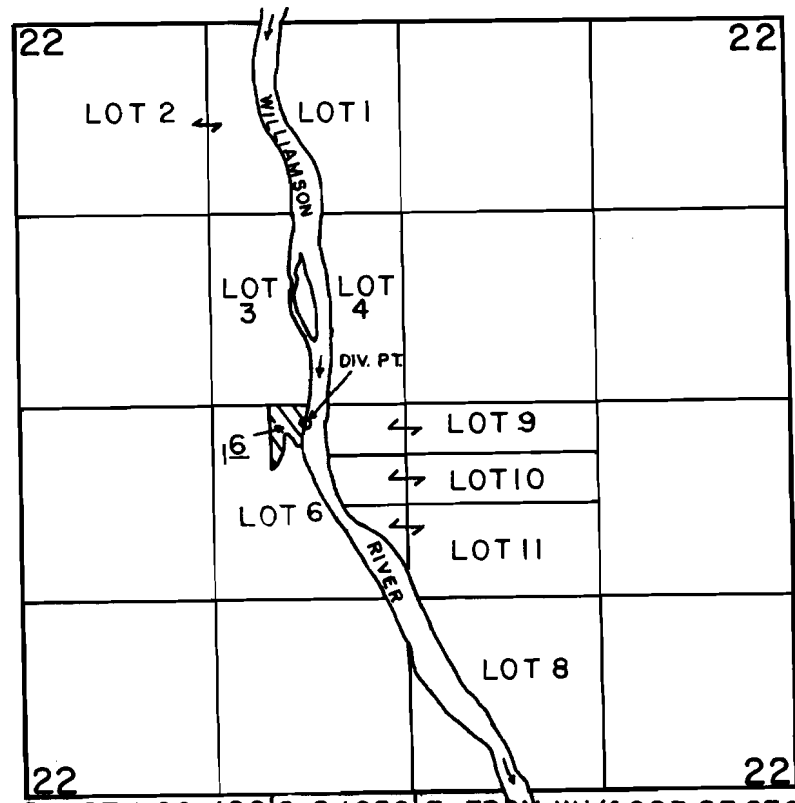

DIV. PT LOC: 120' S. & 1950' E. FROM W1/4 COR. OF SEC 22.

SCALE: 1" = 1320'

**FINAL PROOF SURVEY
UNDER**

Application No. 58195... Permit No. 43834...
IN NAME OF

.....JIMMIE LEE VAN PELT.....

Surveyed JUNE 27 1991, by B.W. BISHOP...

Williamson Riv. Blk. H. Marsh