


T. 41 S., R. 13 W., W.M.

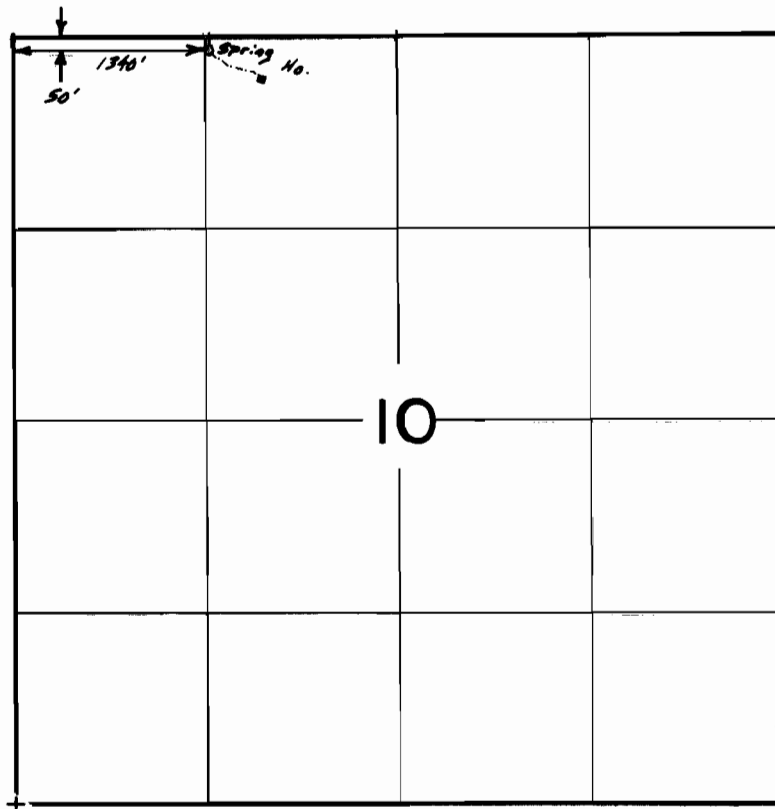

Scale 1"=1320'



FINAL PROOF SURVEY
UNDER

Application No. 59866 Permit No. 44988...
IN NAME OF

.....LAURENCE.....WALLIN.....

Surveyed Nov. 6, 1991, by B.S. JAMES...