


T. 35 S., R. 14 W., W.M.

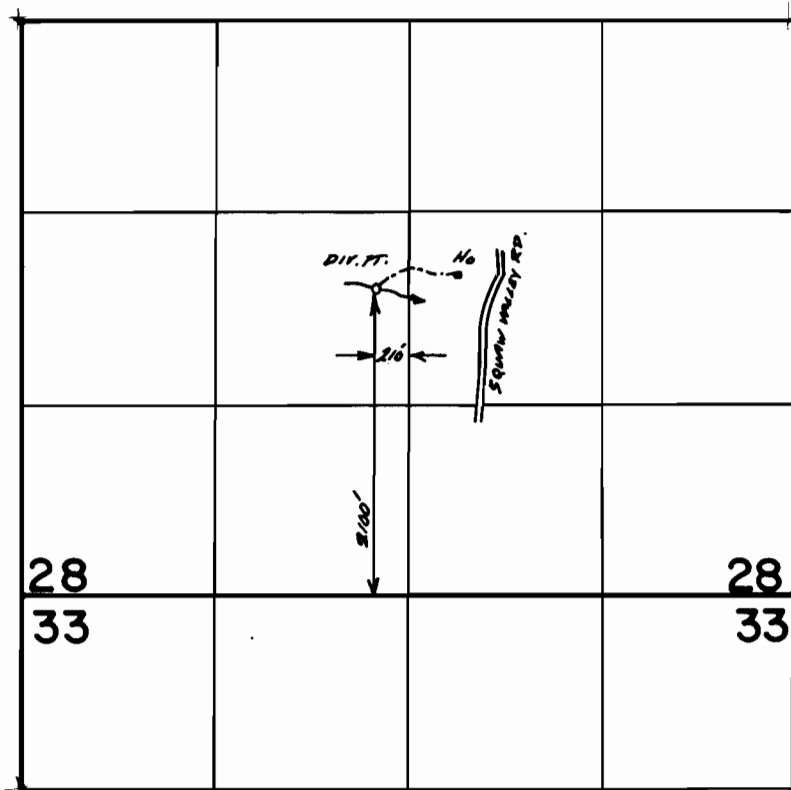

Scale 1" = 1320'

**FINAL PROOF SURVEY
UNDER**

Application No. 60523 Permit No. 45333...
IN NAME OF

..RONALD... & ...SANDRA.....WAMPACH

Surveyed Sept. 25, 1991, by B.S. JAMES....