


T. 32 S., R. 15 W., W.M.

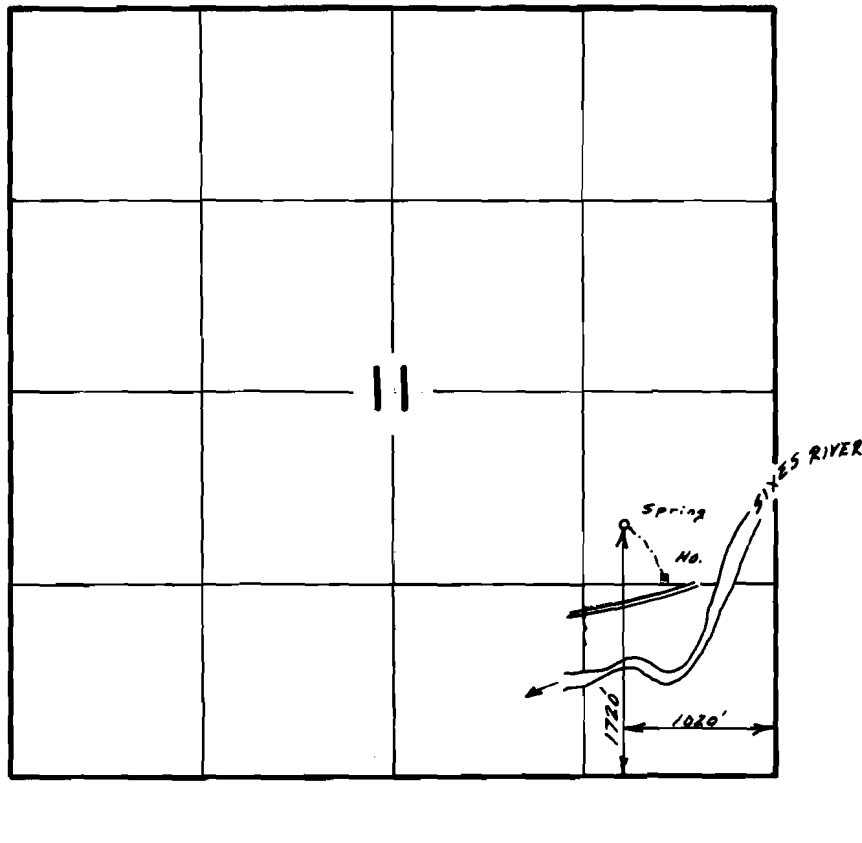

Scale : 1" = 1320'

**FINAL PROOF SURVEY**  
UNDER

Application No. 63686 Permit No. 46875...  
IN NAME OF

.....JEFFREY.....MICHAEL.....ELLIOTT.....

Surveyed Sept. 26, 1991., by B.S. JAMES...