



T. 33 S., R. 2 E., W. M.

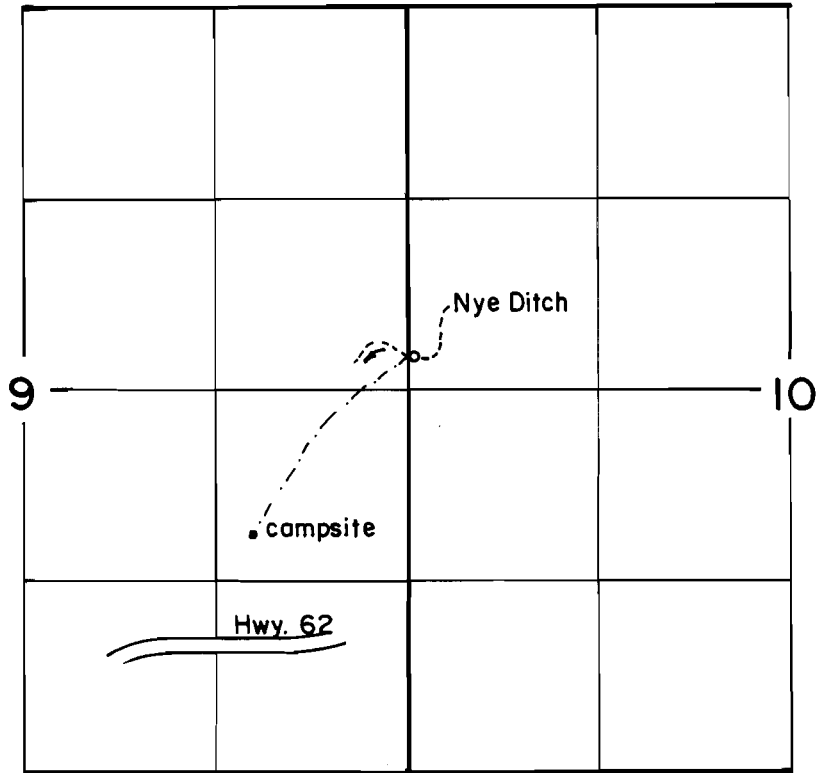

Scale: 1" = 1320'

T.32S.,R.3E., SEC. 29

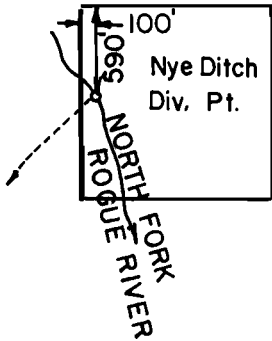

NW 1/4 SW 1/4

FINAL PROOF SURVEY
UNDER

Application No. 63830 Permit No. 47156....
IN NAME OF

DOUGLAS C. & DIANE M. McMAHAN

Surveyed JUNE 4, 1991., by L.M. JOACHIMS