



T. 33 S., R. 2 E., W. M.

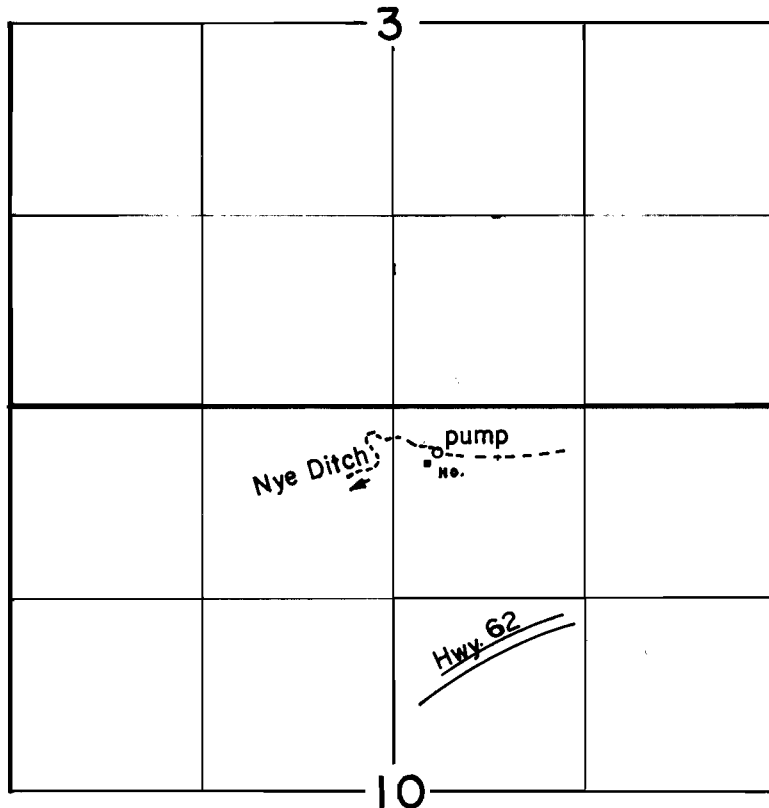

Scale : 1" = 1320'

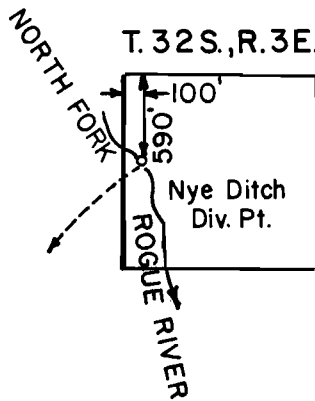

T. 32 S., R. 3 E., SEC. 29

NW 1/4 SW 1/4

### FINAL PROOF SURVEY UNDER

Application No. ~~63839~~ Permit No. ~~47087~~.....  
IN NAME OF

.....WILLIAM T. SCRIVEN.....

Surveyed JUNE 4 1991, by L. M. JOACHIMS