


16 2W 3

S e e                      M a p                      1 5                      2 W                      3 4

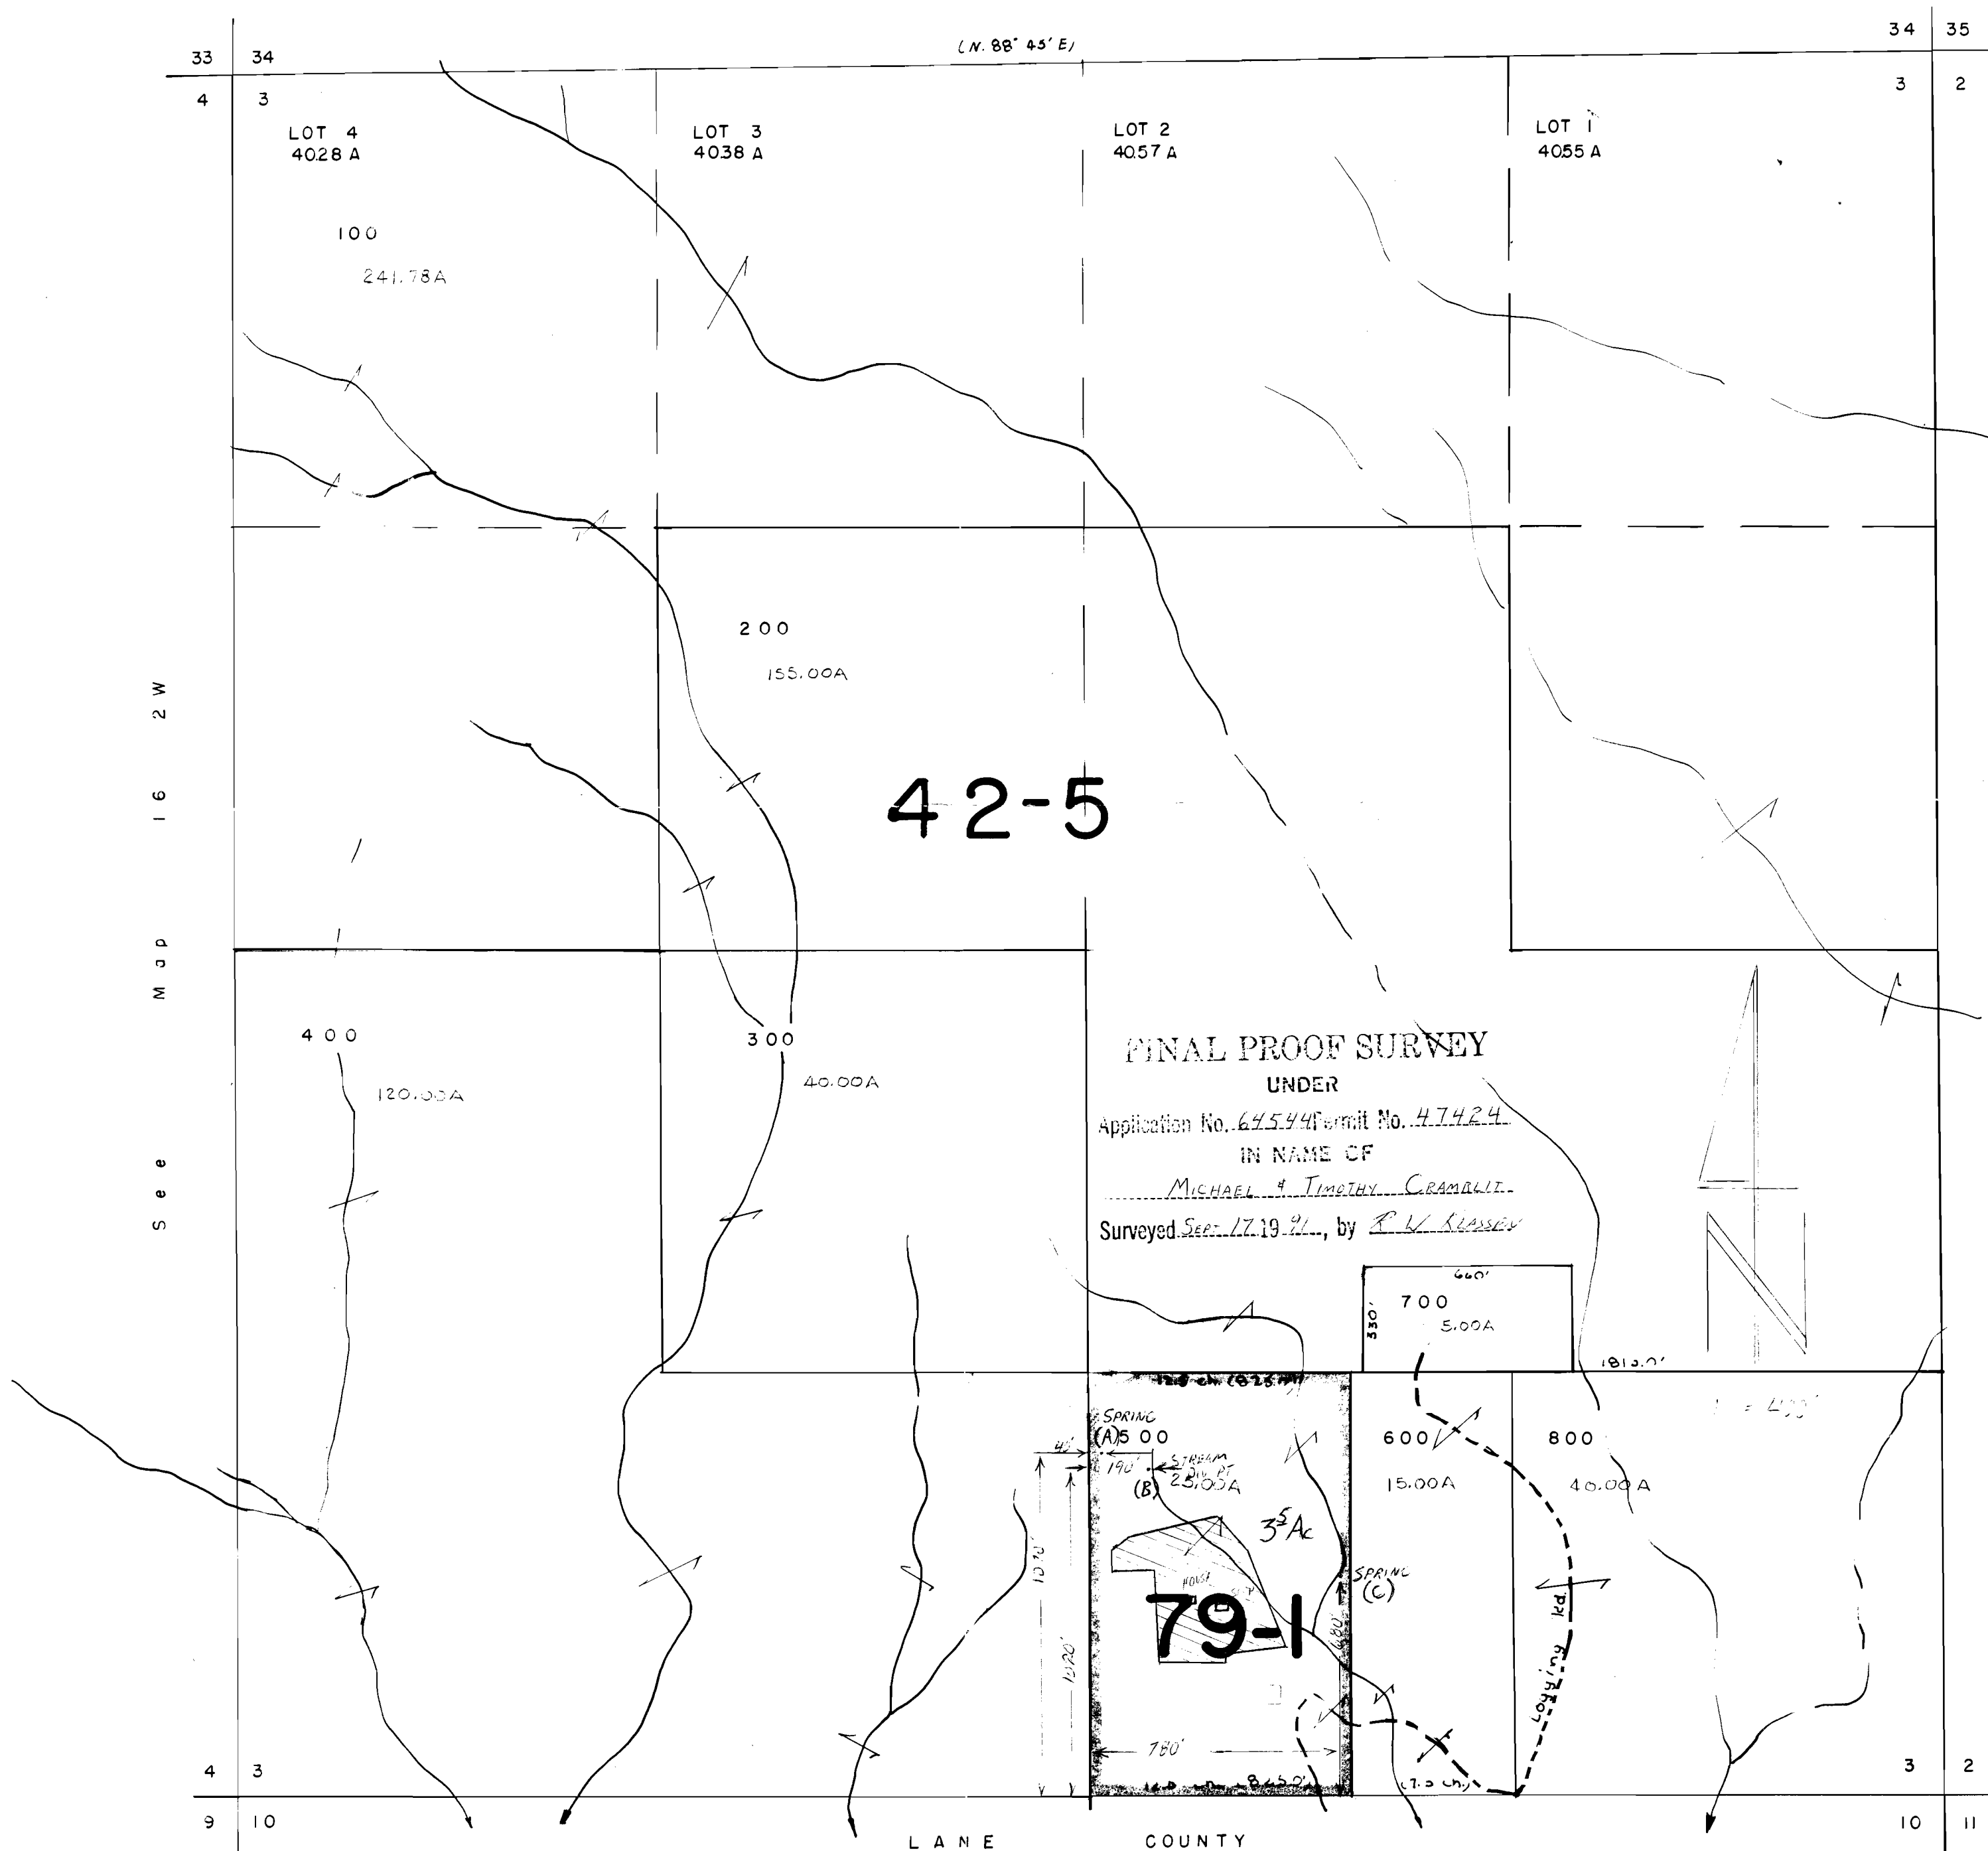

16 2W 3