


T. 37 S., R. 9 W., W. M.

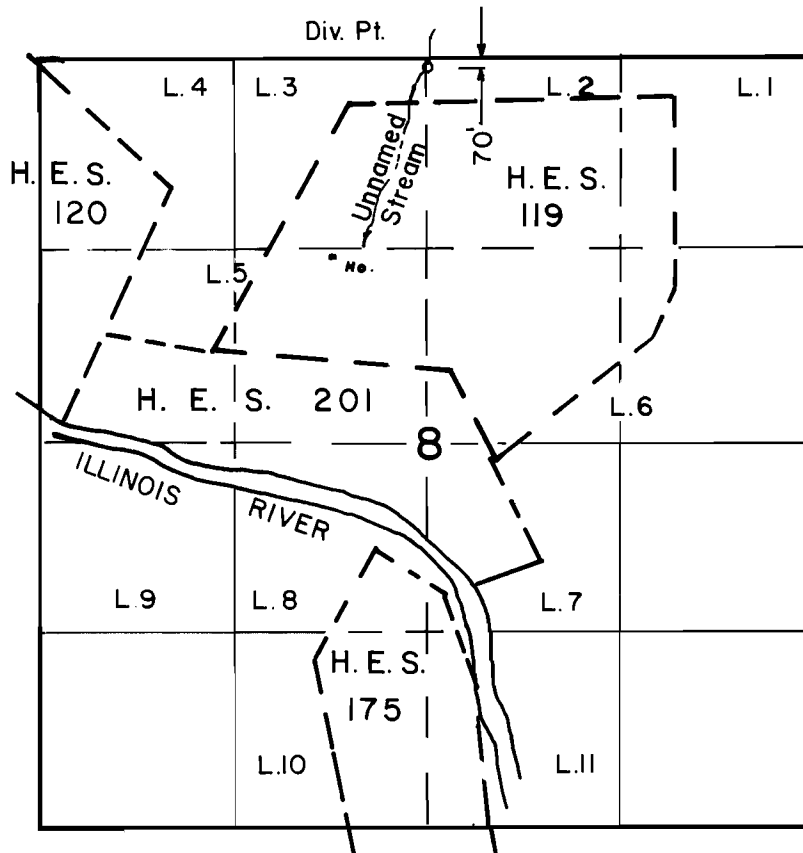

Scale: 1" = 1320'

FINAL PROOF SURVEY
UNDER

Application No. ~~64842~~ Permit No. ~~47633~~...
IN NAME OF

...W. STEVEN WALLMANN...

Surveyed JULY 10, 1991, by B. S. JAMES...