


T. 32 S., R. 2 E., W. M.

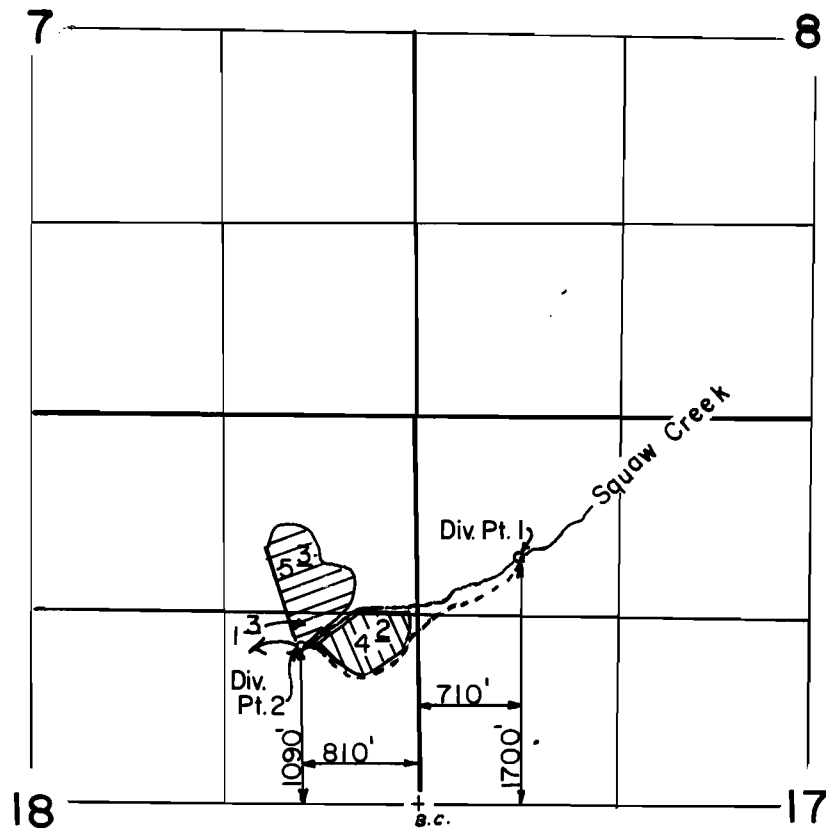

Scale: 1" = 1320'

FINAL PROOF SURVEY
UNDER

Application No. 65013. Permit No. 47467....
IN NAME OF

DONALD RAY & PHYLLIS M. NELSON

Surveyed AUG. 14. 1991., by B.S. JAMES...

41033-419-159K

1/92 JMS