


48478
67607

T.36S., R.13E., W.M.

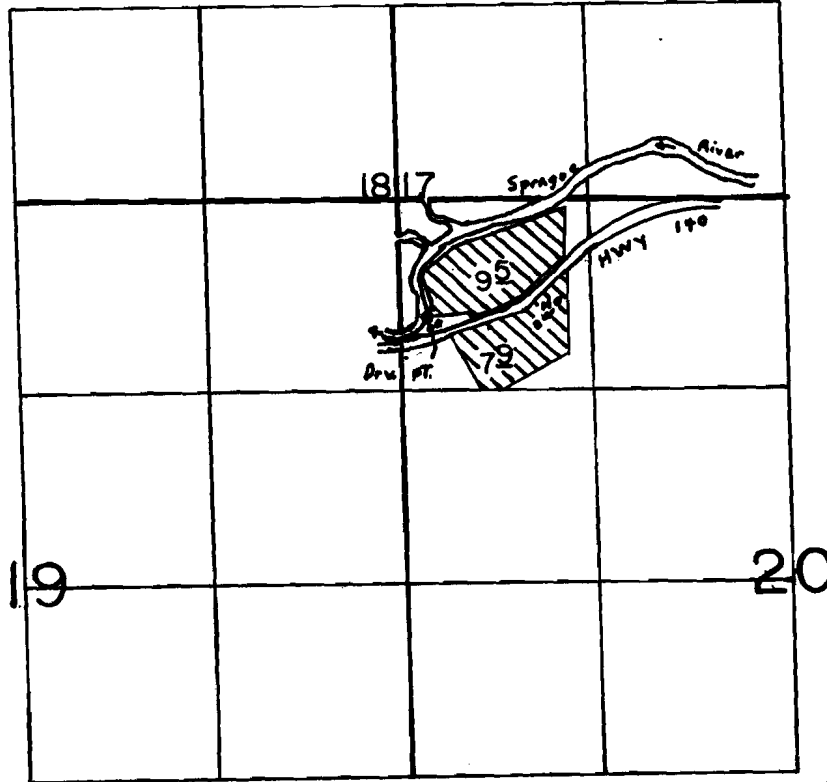

DIR.PT.LOC:820'S&180'E. FROM NW COR. OF SEC 20.

SCALE 1" = 1320'

FINAL PROOF SURVEY
UNDER

Application No. 66271. Permit No. 48478.....
IN NAME OF

.....GARY..M...S.STRONG.....

Surveyed JULY.24. 19.91., by R.W..BISHOP.....

Sprague River