


RECEIVED
OCT 2 1983
WATER RESOURCES DEPT.
SALEM, OR

T. 24S. R. 7W.

2

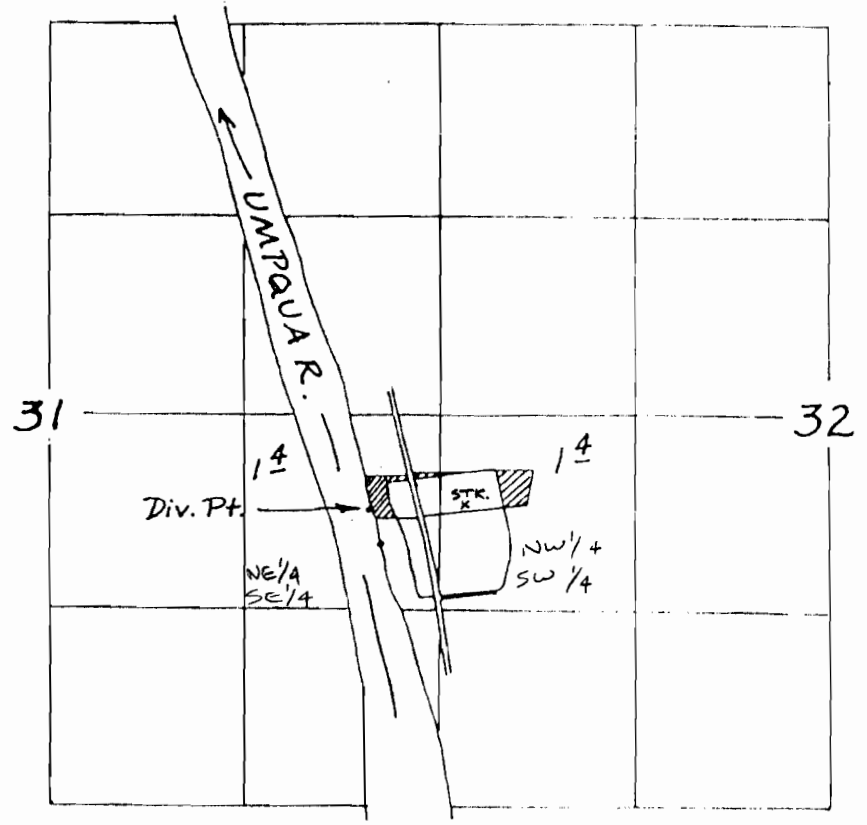

Scale: 4" = 1 mile

Div. Pt. 640' S. and 470' W.
from E 1/4 cor. Sec. 31

Application No. 67352
Permit No. 48159