


T. 24 S., R. 7 W., W. M.

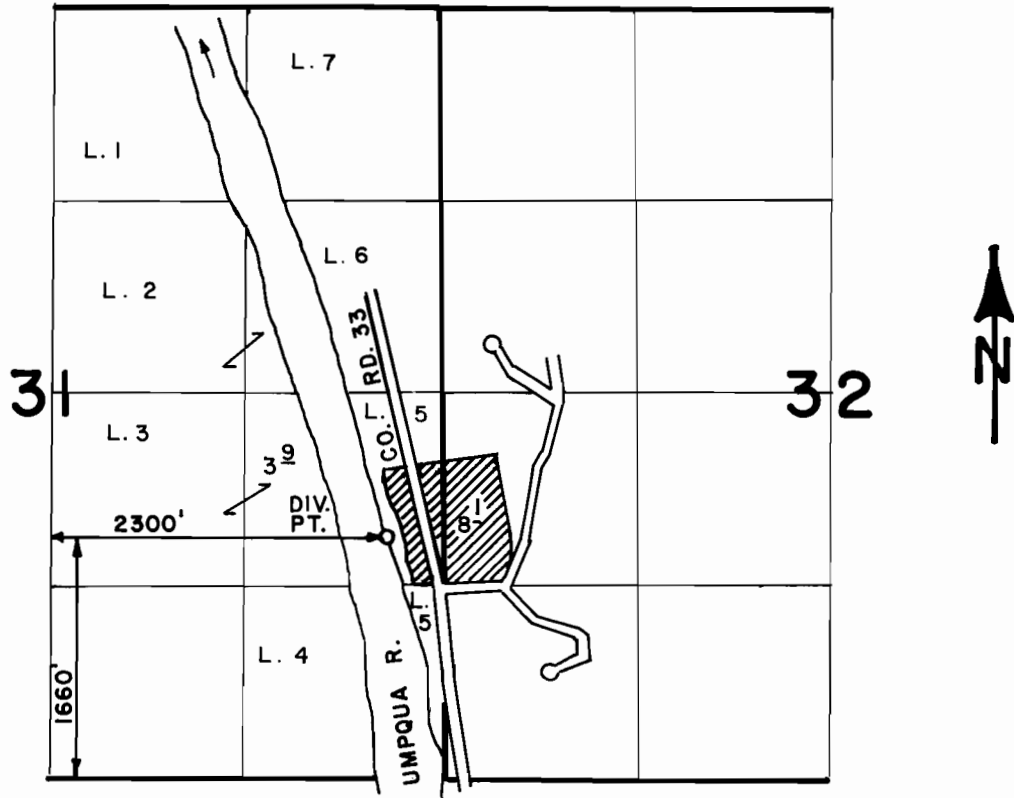

SCALE: 4" = 1 MILE

FINAL PROOF SURVEY
UNDER

Application No. 49090 Permit No. 36825.....
IN NAME OF

..... **ROY W. STEPHENSON**

Surveyed JUNE 5... 1975, by L. E. GOULD.....