


T. 12 S., R. 4 W., W.M.

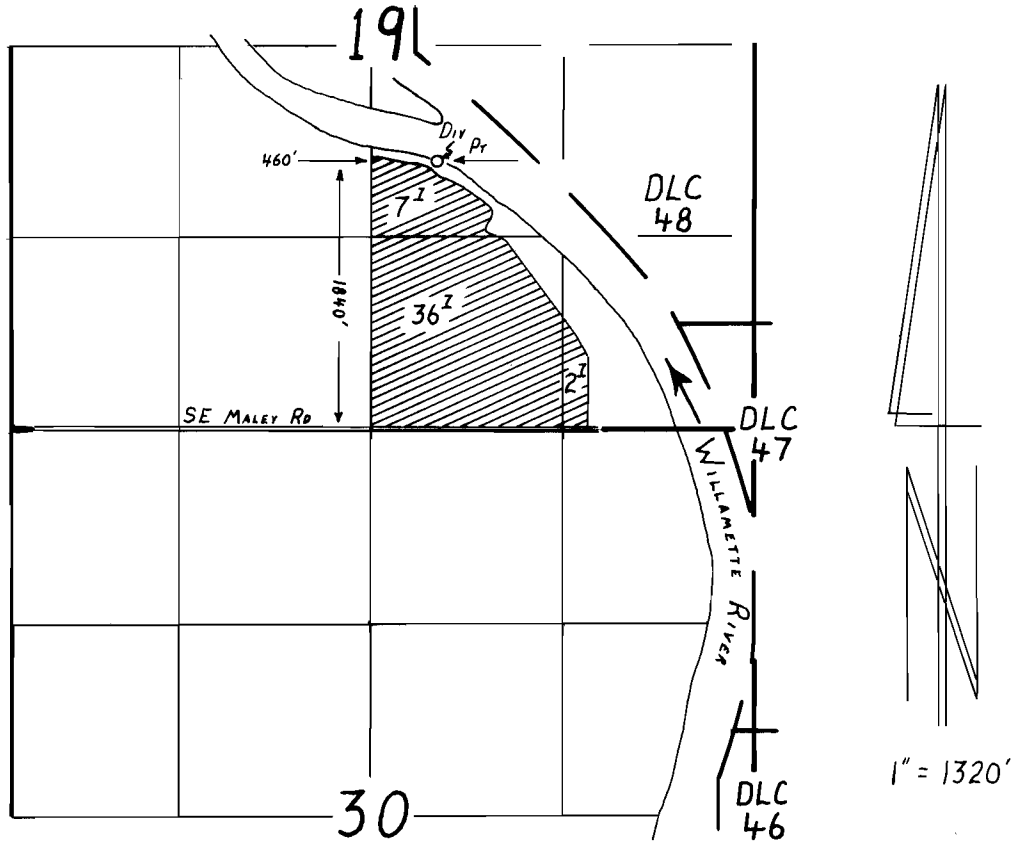

FINAL PROOF SURVEY

UNDER

Application No. 68738 Permit No. 49717

IN NAME OF

DONALD W. GODARD

Surveyed March 15, 1991, by R.W. Klassen