


T. 34S., R. 7E., W.M.

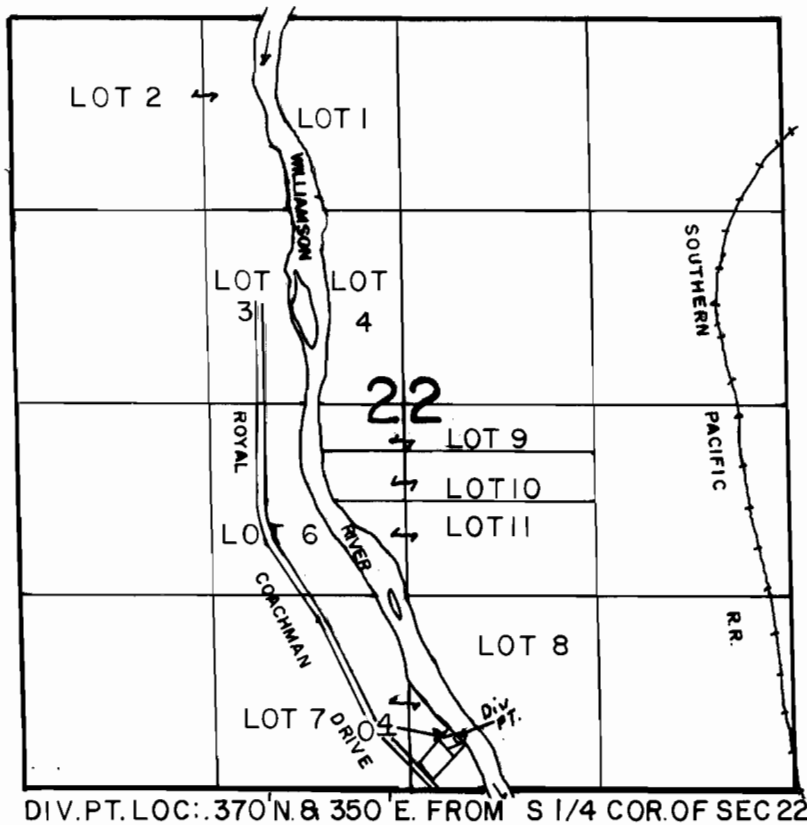

SCALE: 1" = 1320'

FINAL PROOF SURVEY UNDER

Application No. 68864 Permit No. 49943.....
IN NAME OF

.....THELMA...JONES...HAZEL.....

Surveyed JUNE 27, 1991., by ..R.W..BISHOP.