


T. 1 S. R. 39 E. W. M.

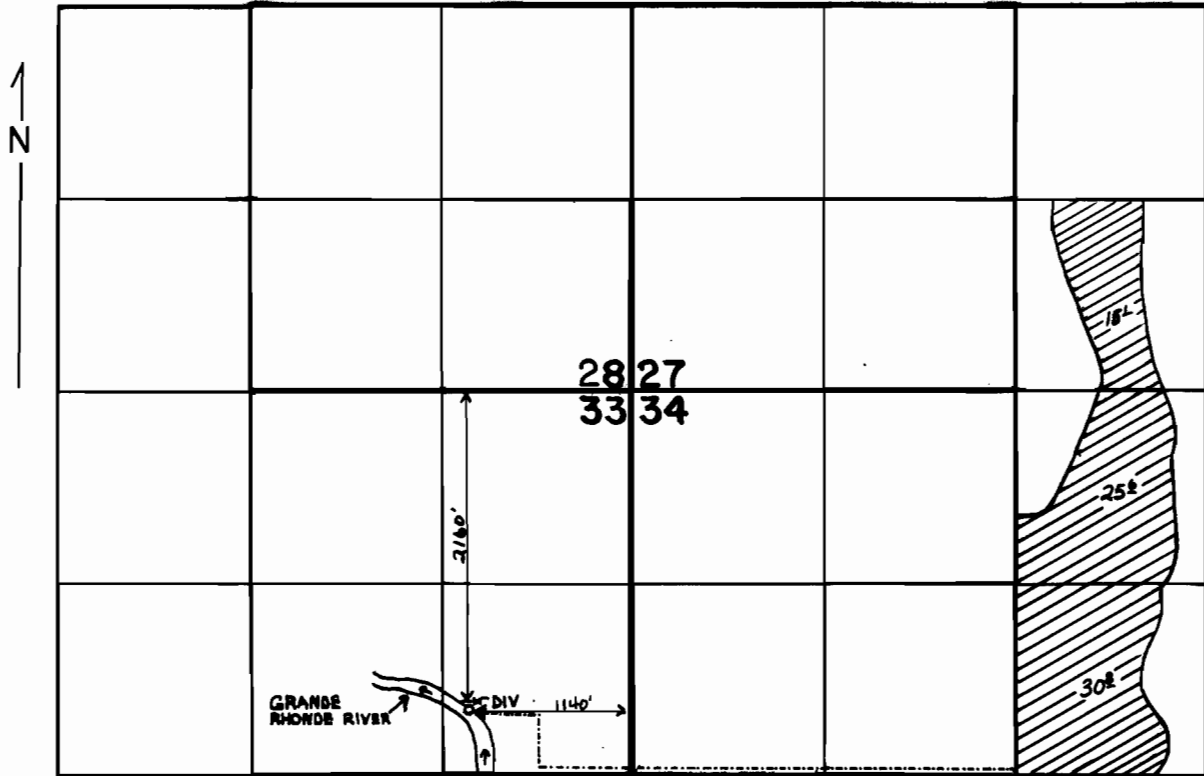

4" = 1 MILE

FINAL PROOF SURVEY UNDER

Application No. **68948** Permit No. **49966**...
IN NAME OF

.....**RUSSELL H. BINGAMAN**.....

Surveyed **7-19** 19**91**, by **J. Miller**.....

A-1H-1mm-91
NCR
gmm 1-22-92