

FINAL PROOF SURVEY MAP

AUG 23 1991

IN THE NAME OF DORIS I. MATTHEWS

THE RESOURCES DEPT
Salem, Oregon



SECTION 2, T28S, R8W, W.M.

APPLICATION 70158

PERMIT 51084



1 INCH = 1320 FEET

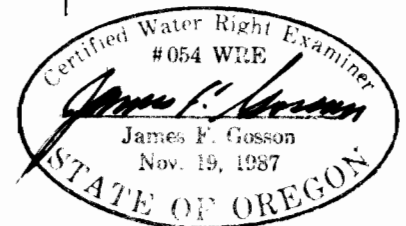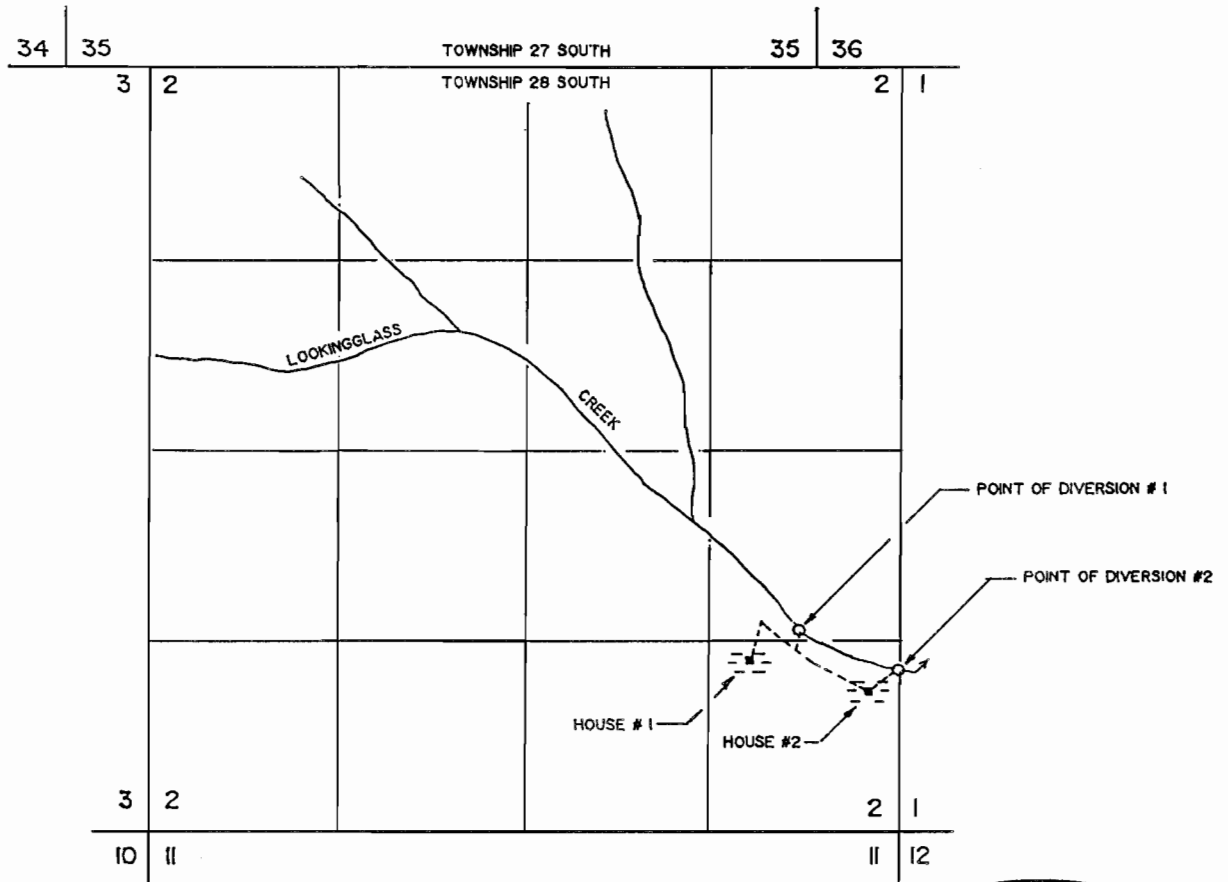

POINT OF DIVERSION #1 IS LOCATED 1420 FEET NORTH AND 700 FEET WEST FROM THE SOUTHEAST CORNER OF SECTION 2, BEING WITHIN THE SE 1/4 OF THE SE 1/4 OF SECTION 2, TOWNSHIP 28 SOUTH, RANGE 8 WEST, W.M., DOUGLAS COUNTY.

POINT OF DIVERSION #2 IS LOCATED 1140 FEET NORTH AND 30 FEET WEST FROM THE SOUTHEAST CORNER OF SECTION 2, BEING WITHIN THE SE 1/4 OF THE SE 1/4 OF SECTION 2, BOTH BEING WITHIN TOWNSHIP 28 SOUTH, RANGE 8 WEST, W.M., DOUGLAS COUNTY.

THE PURPOSE OF THIS MAP IS TO IDENTIFY THE LOCATION OF THE WATER RIGHT. IT IS NOT INTENDED TO PROVIDE INFORMATION RELATIVE TO THE LOCATION OF PROPERTY OWNERSHIP BOUNDARY LINES.