


T. 33 S., R. 1 E., W. M.

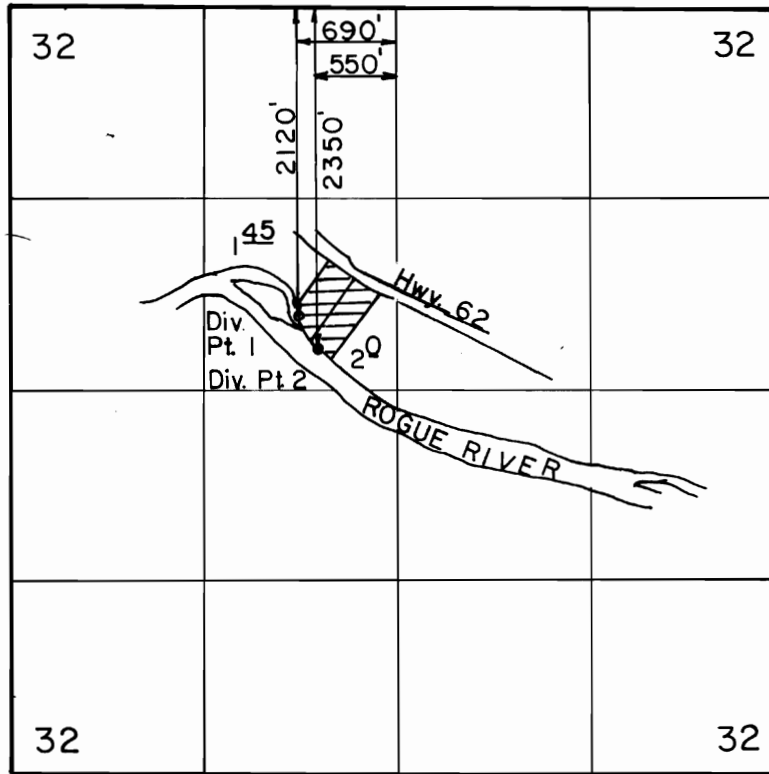

Scale: 1" = 1320'

**FINAL PROOF SURVEY
UNDER**

TRANSFER NO. 5490

Application No. Permit No.
IN NAME OF

.....GALE...R...FULTON.....

Surveyed SEP. 5... 1991., by B. S. JAMES...