


T.34S, R.1W, W.M.

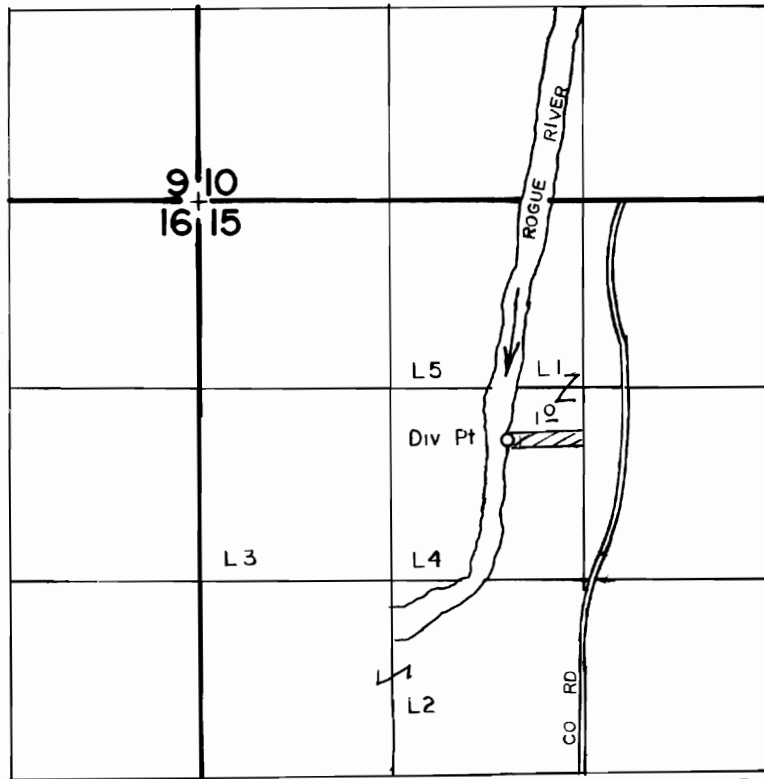

Div Pt Located 1000' N & 510' W From The Center 1/4 Corner Of Section 15

SCALE: 1" = 1320'

**FINAL PROOF SURVEY
UNDER**

TRANSFER NO 5902

Application No. Permit No.
IN NAME OF

JANE L & RENA F. NEUNER

Surveyed MARCH 26 1990., by B.S. JAMES