


# T.34S., R.1W., W.M.

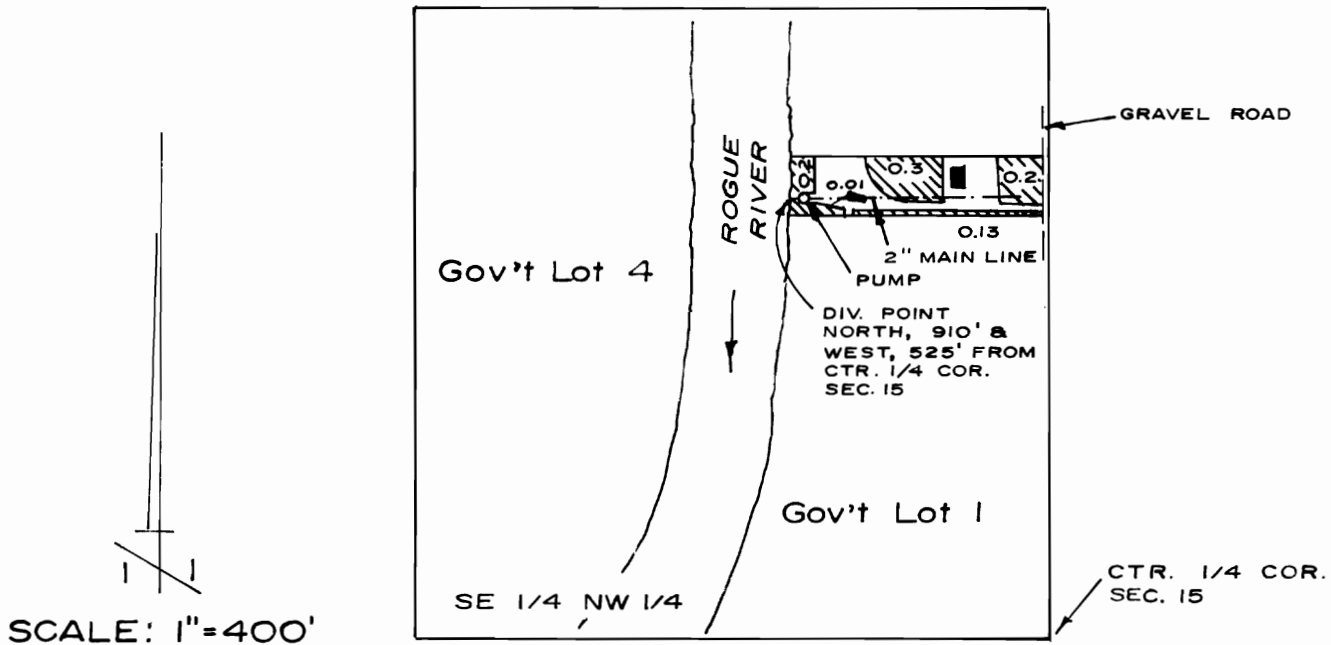

## FINAL PROOF MAP

APPLICATION No. T-5980

NOTE THIS MAP HAS BEEN PREPARED FOR WATER RIGHT PURPOSES ONLY, NOT FOR PROPERTY BOUNDARY LOCATIONS

IN THE NAMES OF

WARD and GEORGINE CADWALLADER

MAP PREPARED JULY 8, 1991 BY GARY D. KAISER

