


T.15S. R.42E. W.M.

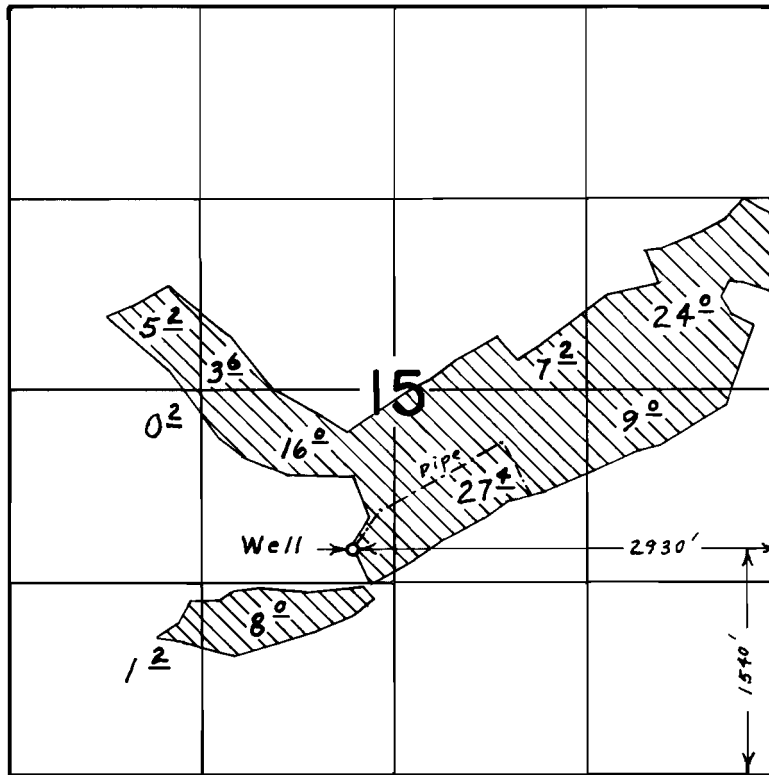

**FINAL PROOF SURVEY**  
UNDER

Application No. G-4784 Permit No. G-4506  
IN NAME OF

*Keith L. McDaniel*

Surveyed May 3, 1976, by L. E. Gould.