


T.28S. R.14W. W.M.

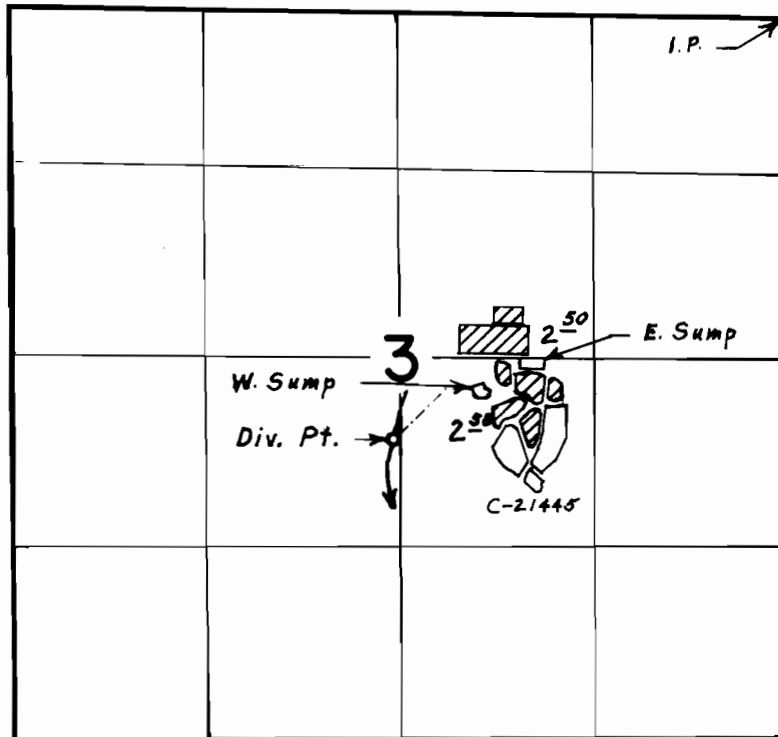

Div. Pt. located 2900' S. & 2680' W. from N. E. Cor. Sec. 3

FINAL PROOF SURVEY UNDER

Application No. 48554. Permit No. 36440.
IN NAME OF

FERN R. PETERSON

Surveyed July 14, 1976, by L. E. Gould.