

15


14

Surveyed Sept. 7 & 8, 1926.

22

23

no river, except in the
3d land, sketched in
on.

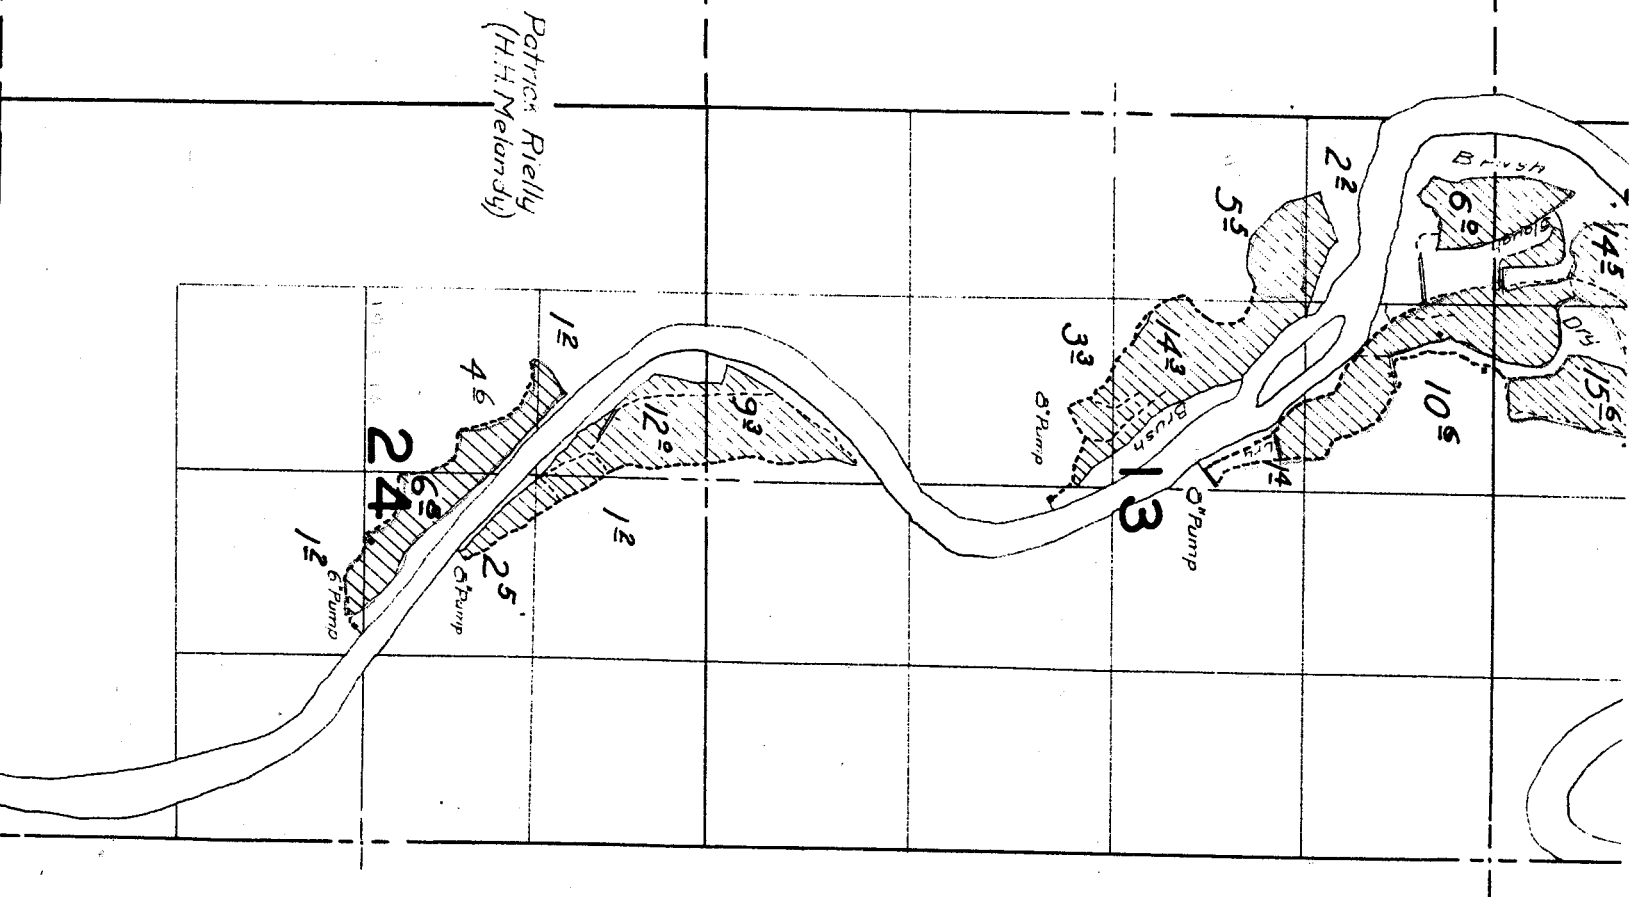

27

26

25


CREEK


CHERRY

34

35

36

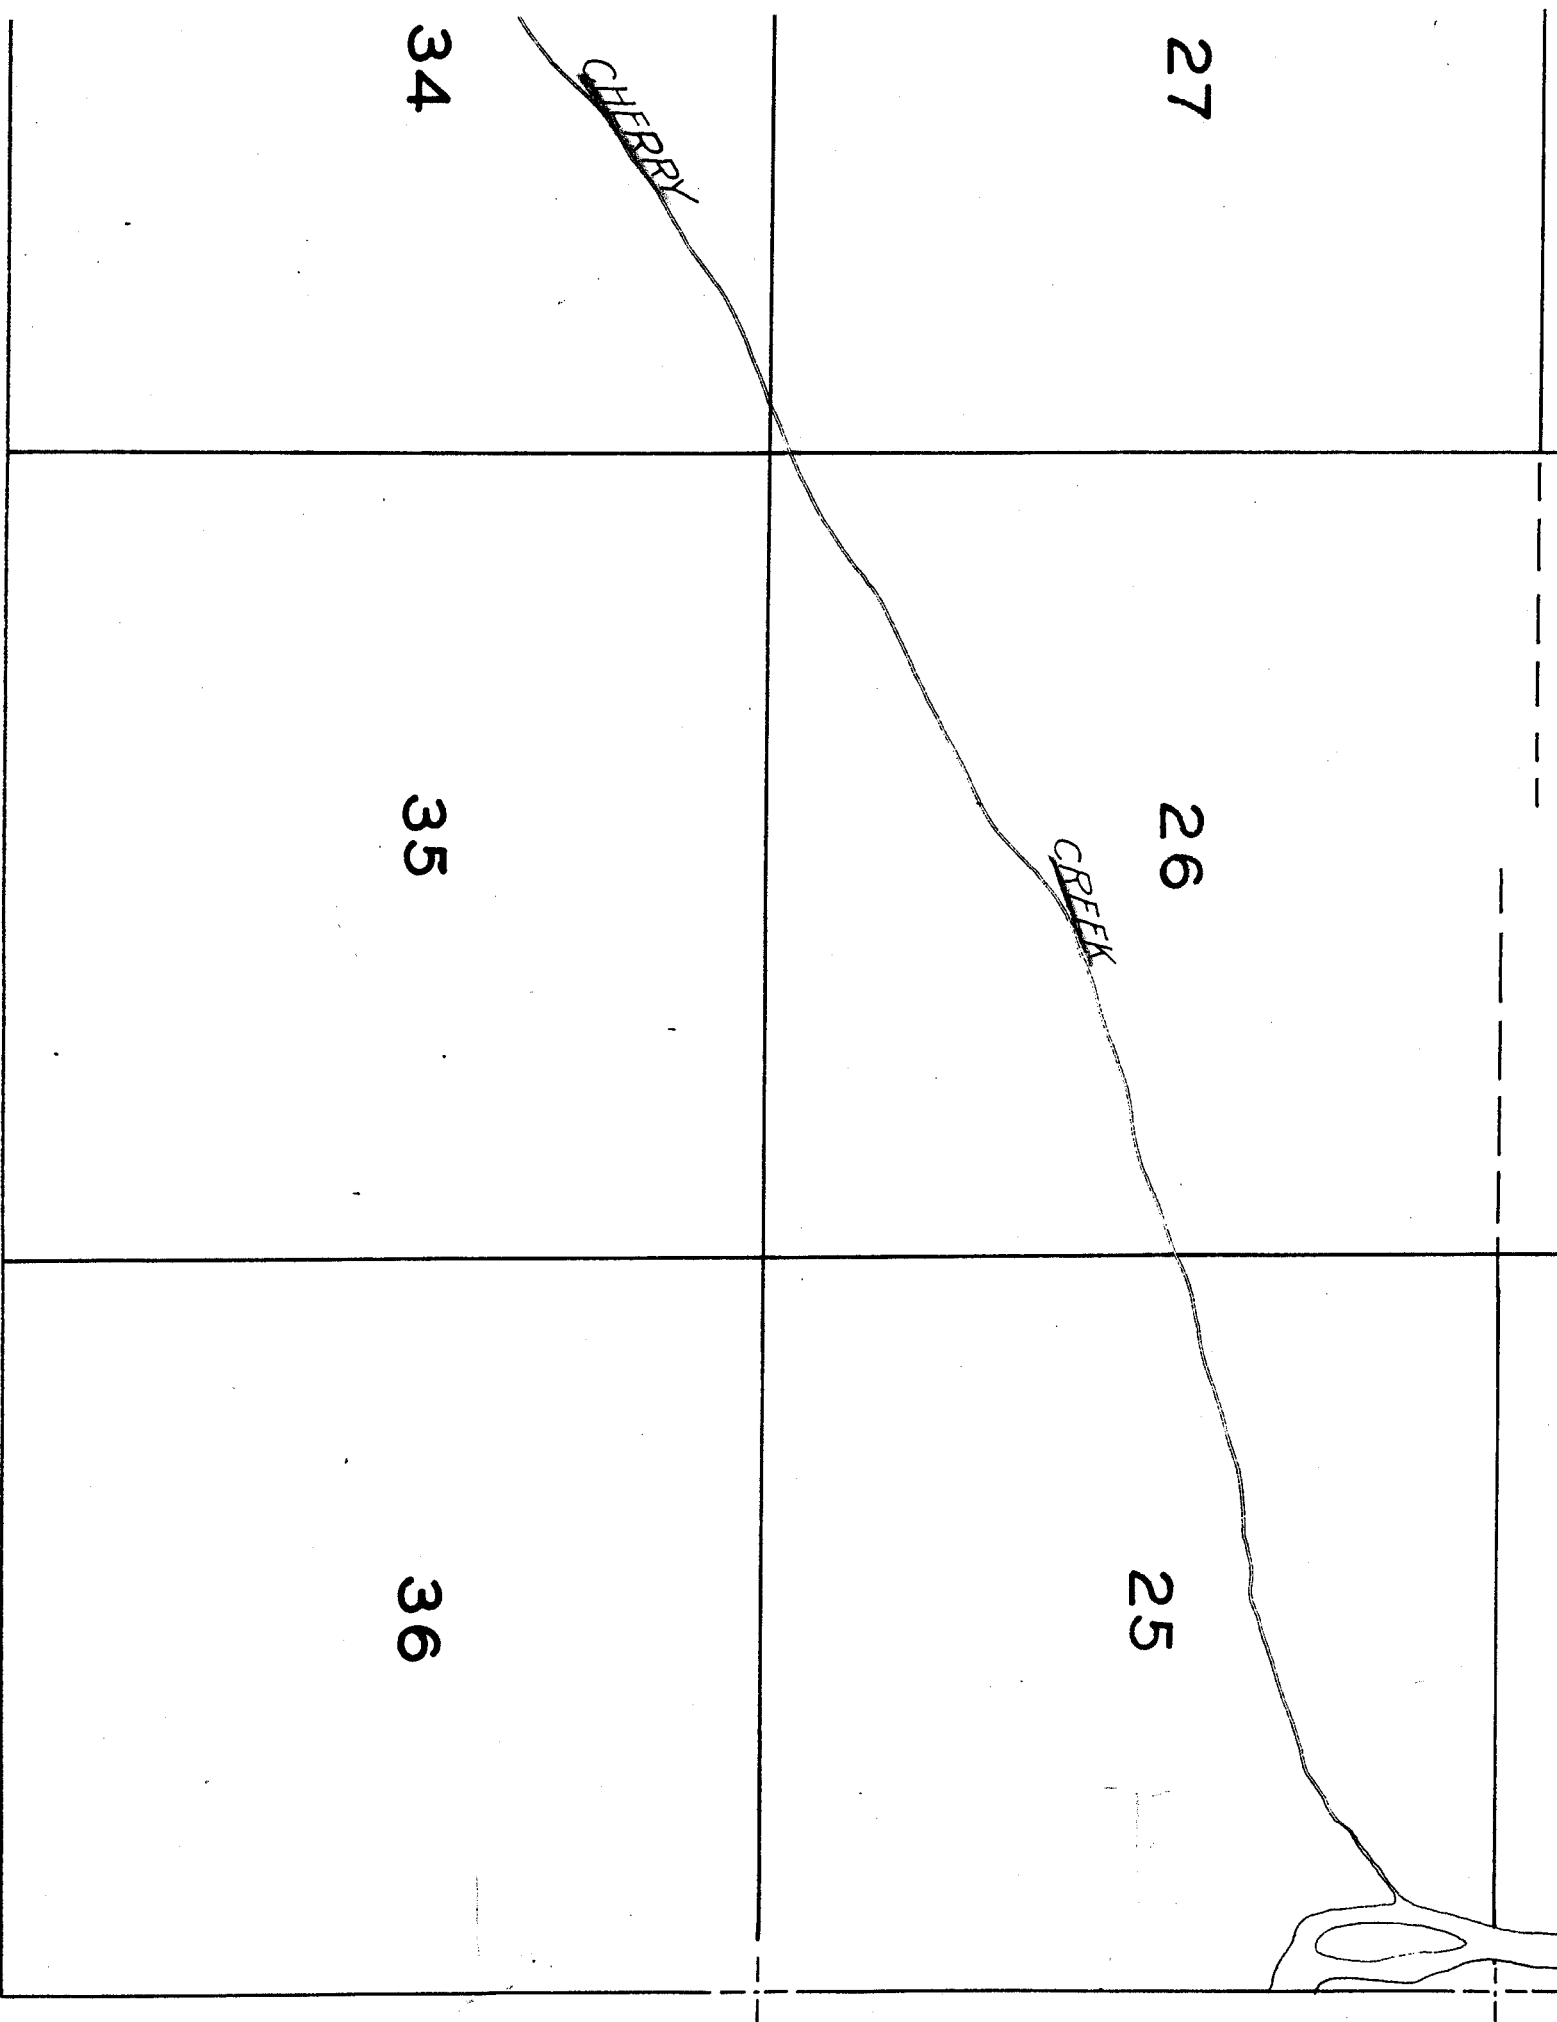

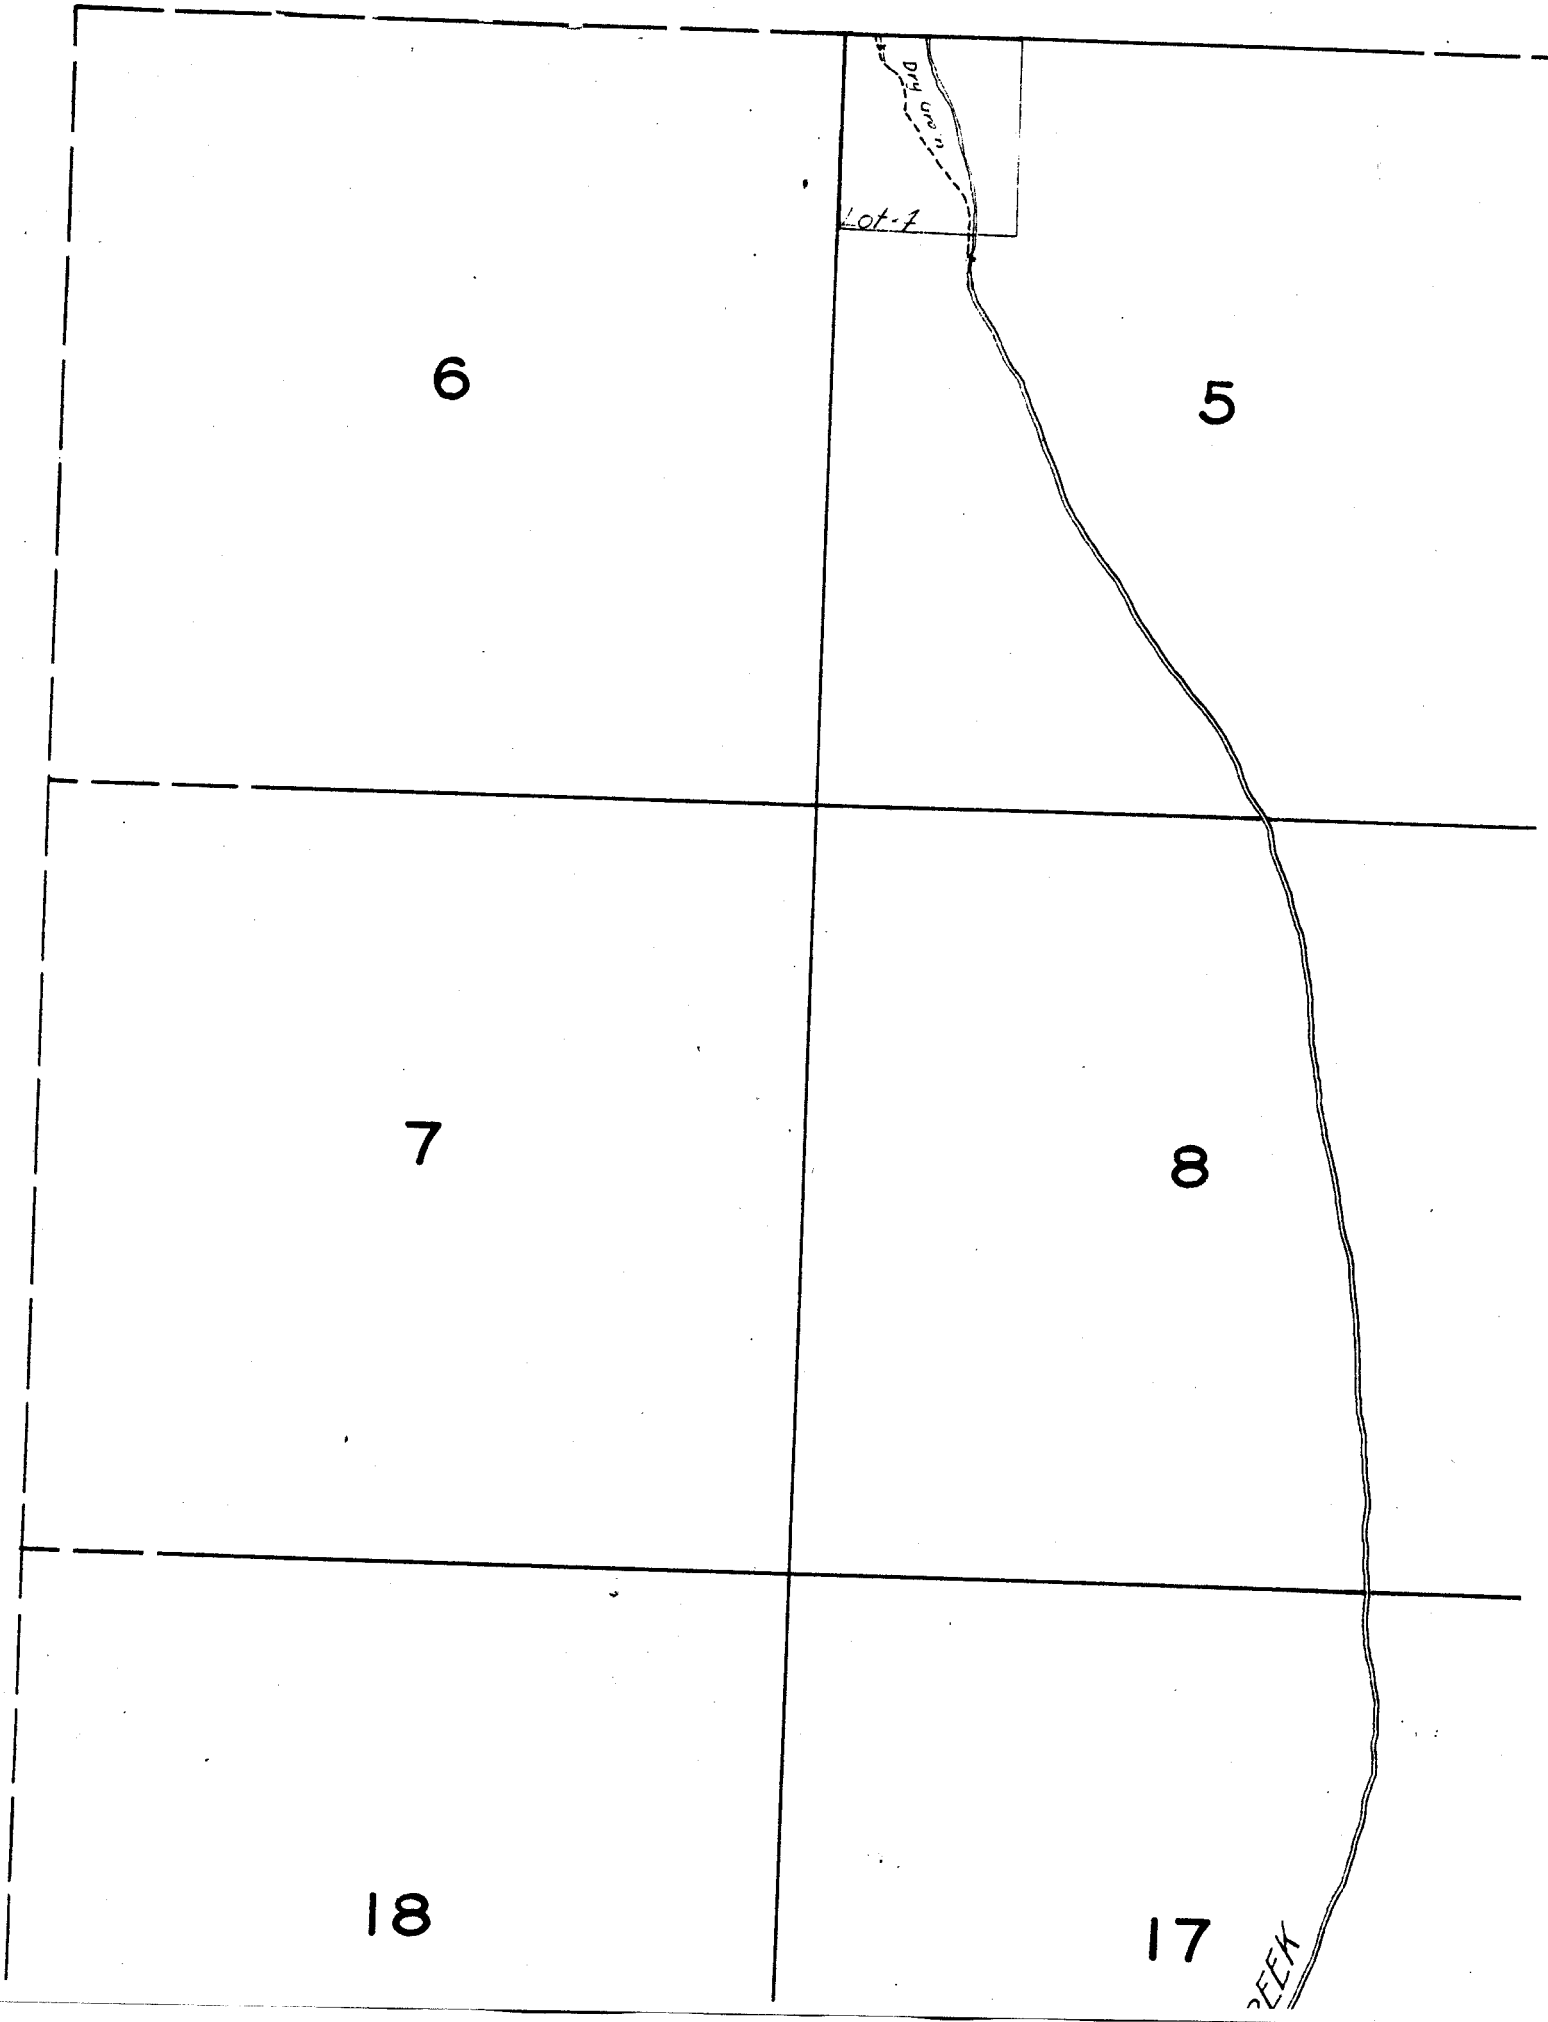

6

5

7

8

18

17


Lot 1

REEK

2

11

14

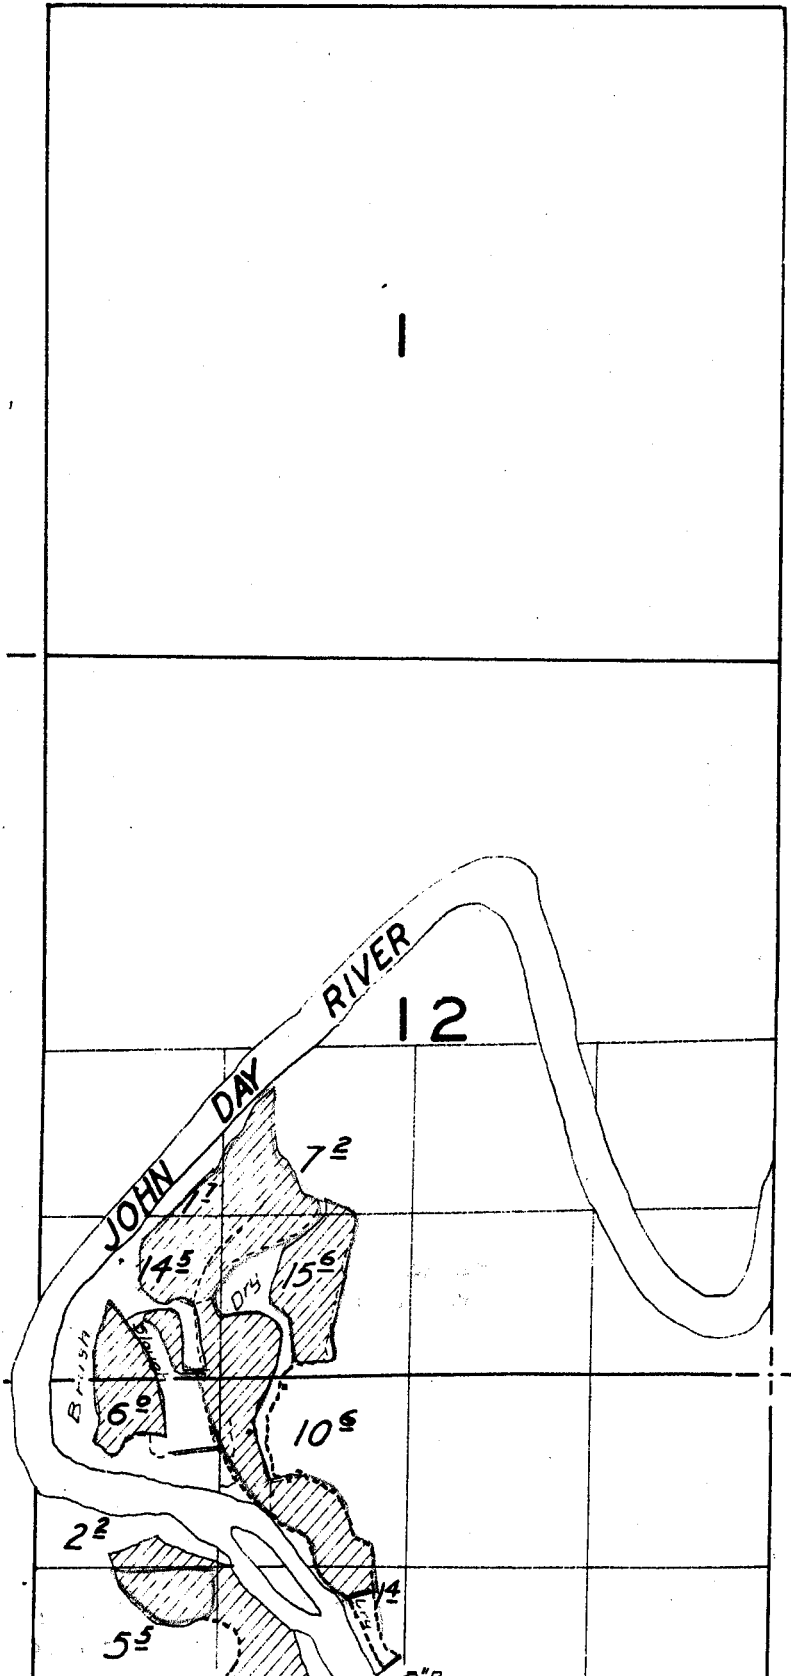

21

22

NOTE: Streams and river, except in the vicinity of irrigated land, sketched in approximate location.

28

27

33

34

CHERRY

TOWNSHIP 9 S. RANGE 19 E.

3

10

4

9

Surveyed 5e

15

16

22

21

NOTE: Streams and river, except in the vicinity of irrigated land, sketched in approximate location.

CEK

Surveyed Aug. 27, 1926.

Lot 2

Junipers

0 3

30 3

Lot 3

11 5

1 6

Flume

3 1

Prineville Land & Livestock Co
James Scott (Sup't)

Lot 4

29

28

31

32

33

Surveyed Aug. 27, 1926.

18

19

17

20

16

21

MUDDY

CREEK

