T. 4 S. R. 2 W. W.M.

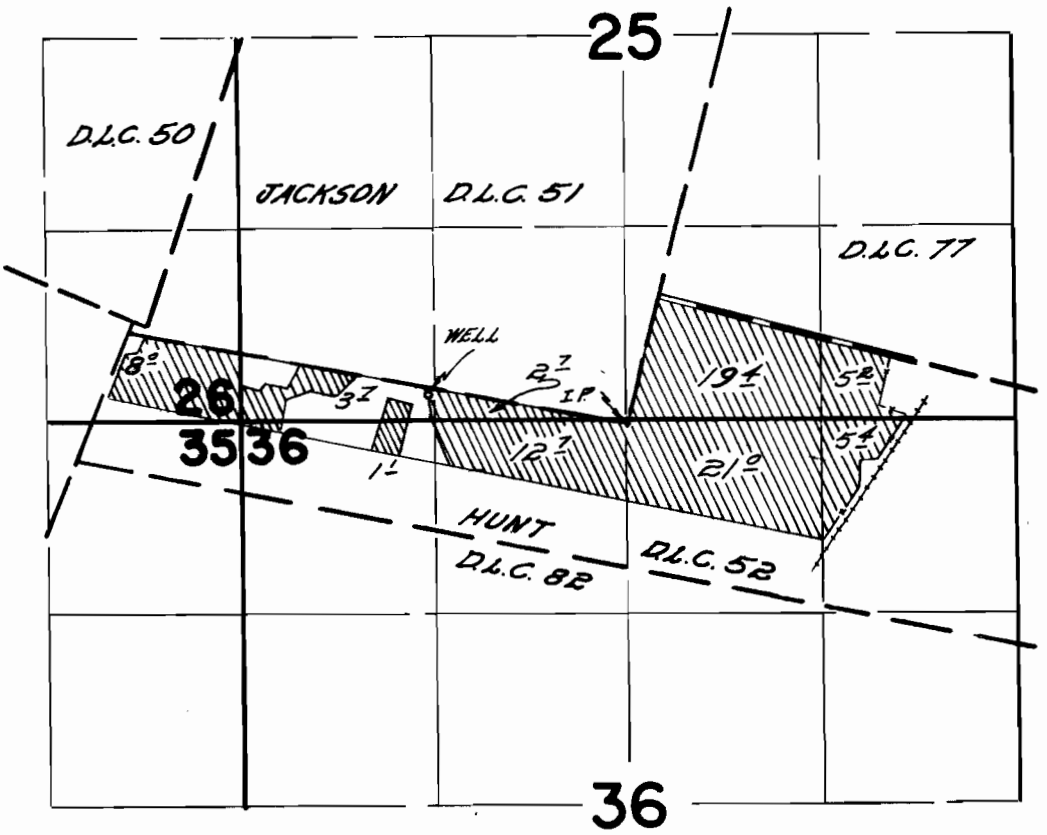

WELL LOCATED 800 FT. N & 1370 FT. W. FROM S.E. CORNER D.L.C. 51

FINAL PROOF SURVEY
UNDER

Application No. G-3877 Permit No. G-3645
IN NAME OF

JAKE R. SONNEN & SON

Surveyed May 31 1968, by W.V. Ruppert

1968-K

