T.4S.,R.2W.,W.M.

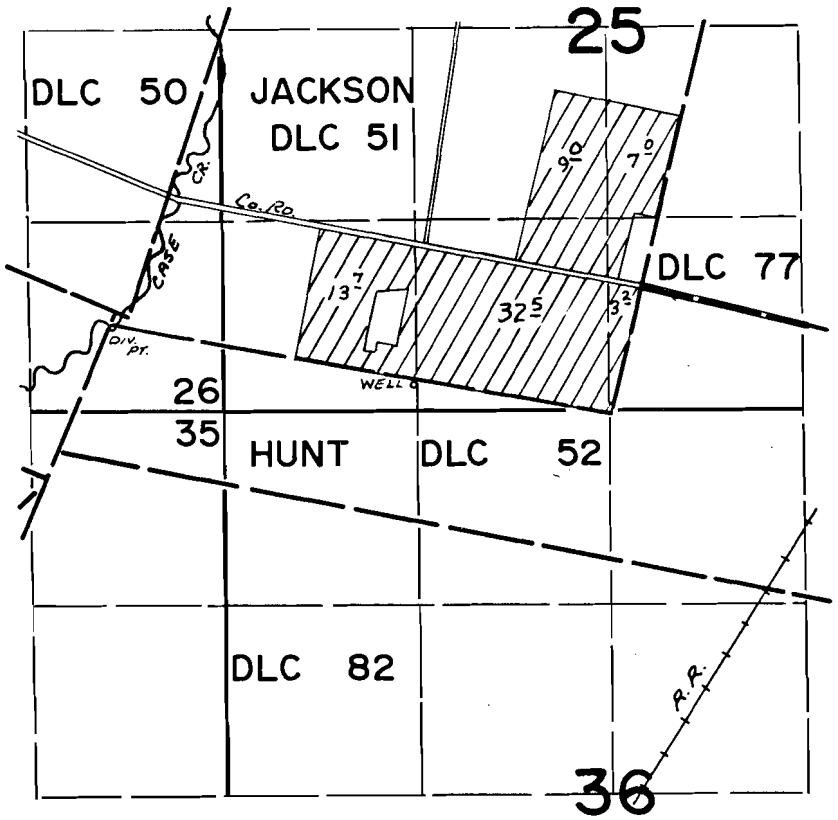

WELL (PRIMARY): 200' N AND 1370' W
CASE CR. DIV. (SUPP'L): 590' N AND 3390' W
} BOTH FROM SE COR. JACKSON DLC 51

FINAL PROOF SURVEY
UNDER

Application No. G-5585 48515 Permit No. G-5443 36400
IN NAME OF

RODERICK J. SONNEN

Surveyed APRIL 19 1976, by L. TOLL

DFN-6LL-193