


T. 40 S., R. 7 & 8 W., W.M.

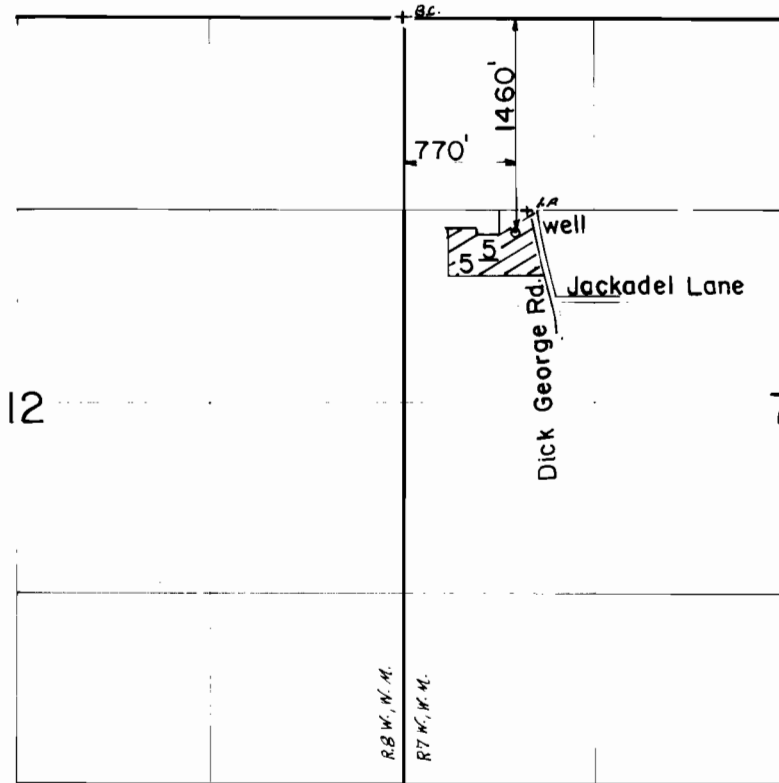

Scale: 1" = 1320'

FINAL PROOF SURVEY
UNDER

Application No. G-7357 Permit No. G-6867
IN NAME OF

LEON G. MORTON

Surveyed A.P.R. 12, 1988, by B. S. JAMES