


T. 38 S., R. 4 W., W. M.

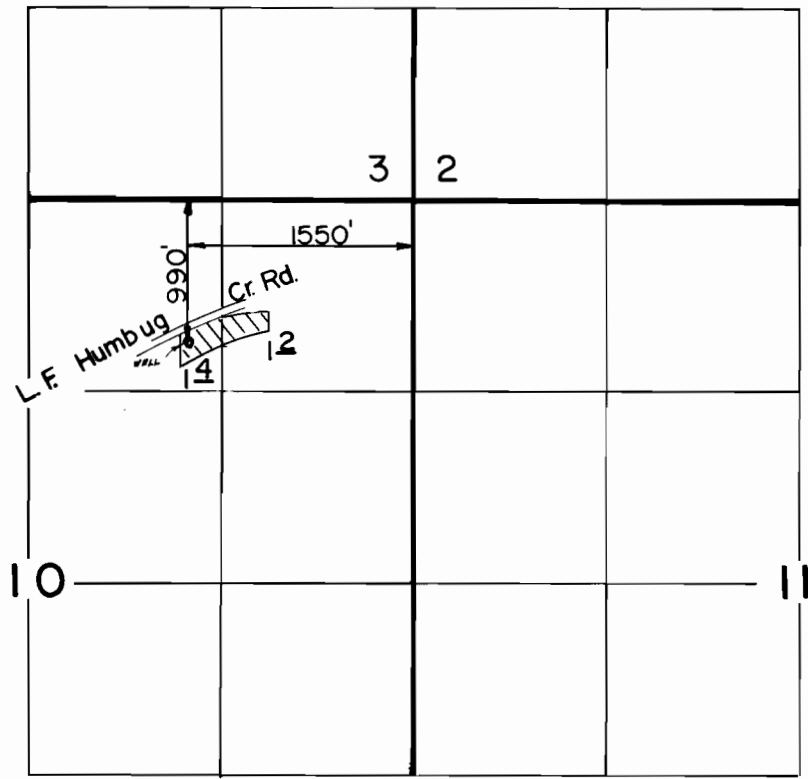

Scale: 1" = 1320'

FINAL PROOF SURVEY
UNDER

Application No. G-7584 Permit No. G-7171.....
IN NAME OF

.....CHARLES.....N.....STEWART.....

Surveyed AUG..2.2. 1988., by B....S....JAMES....