


T.7S.,R.2W.,W.M.

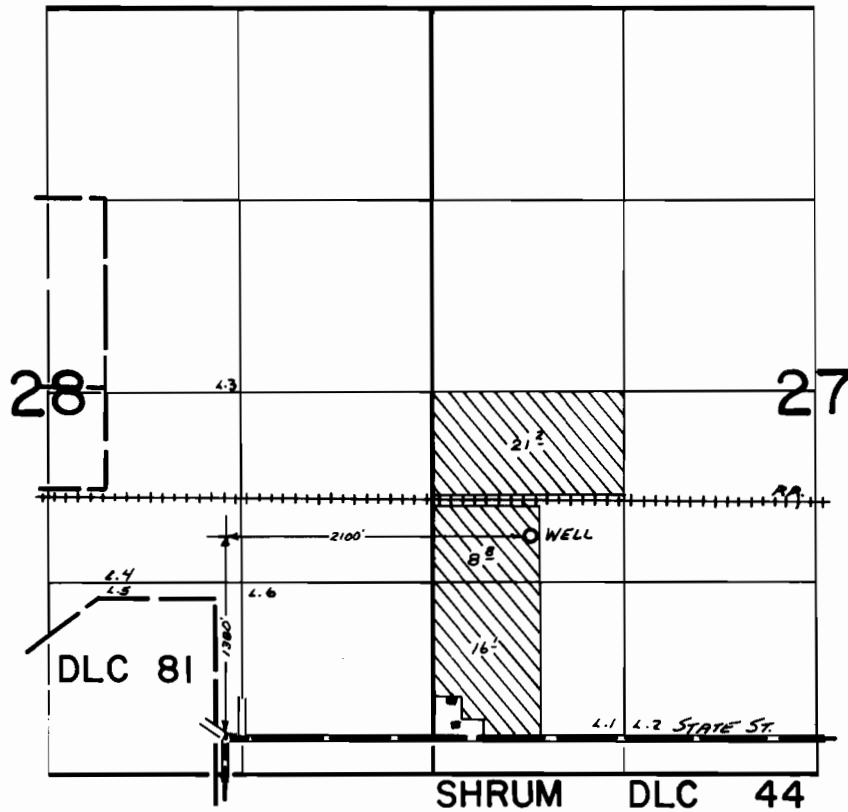

**FINAL PROOF SURVEY**  
UNDER

Application No. G-8172. Permit No. G-7566.....  
IN NAME OF

**MICHAEL EARNEST GERIG**

Surveyed Oct. 28, 1981, by S. C. BROWN.....