


T.15S., R.11E., W.M.

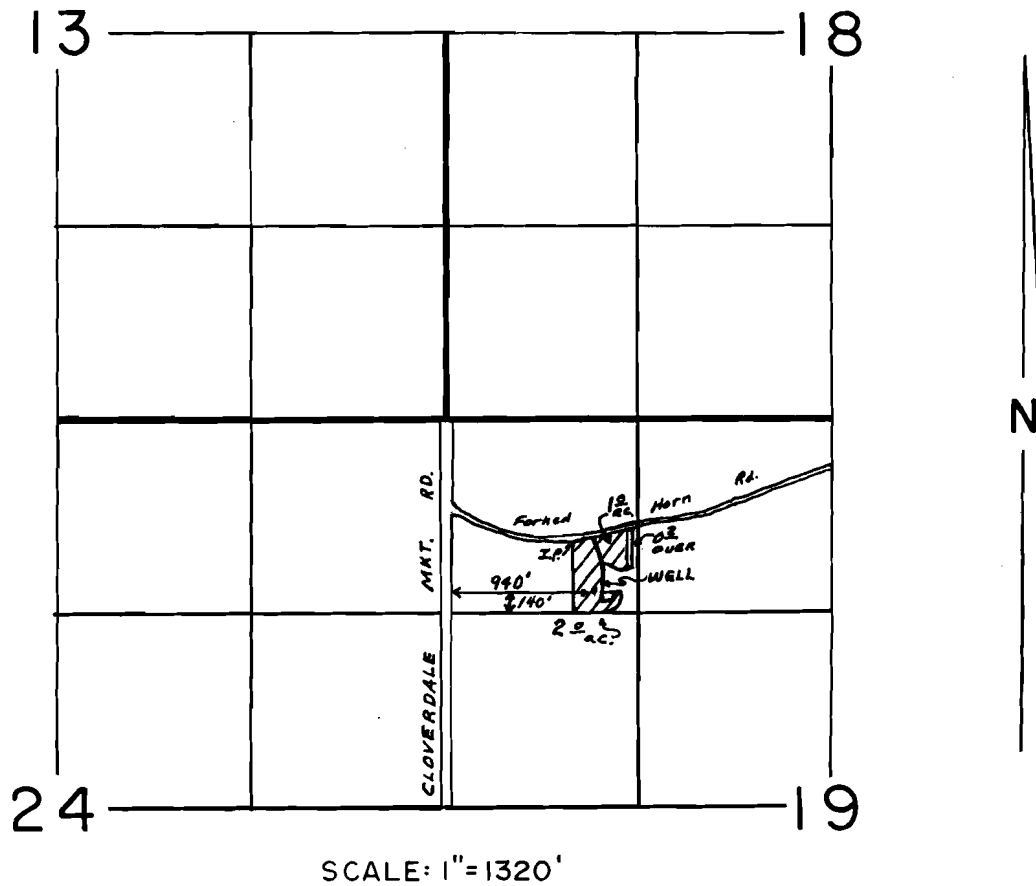

FINAL PROOF SURVEY

UNDER

Application No. **G-8234** Permit No. **G 7684**.....
IN NAME OF

EARL & ARLENE JAKUES

Surveyed NOV. 5 1987, by M.J. MATTICK.

cert. 67651

T/E: 179-254

LLC

G-7684

RECEIVED OCT 30 1992