


G-7609
67652

T. 12S., R. 33E., W. M.

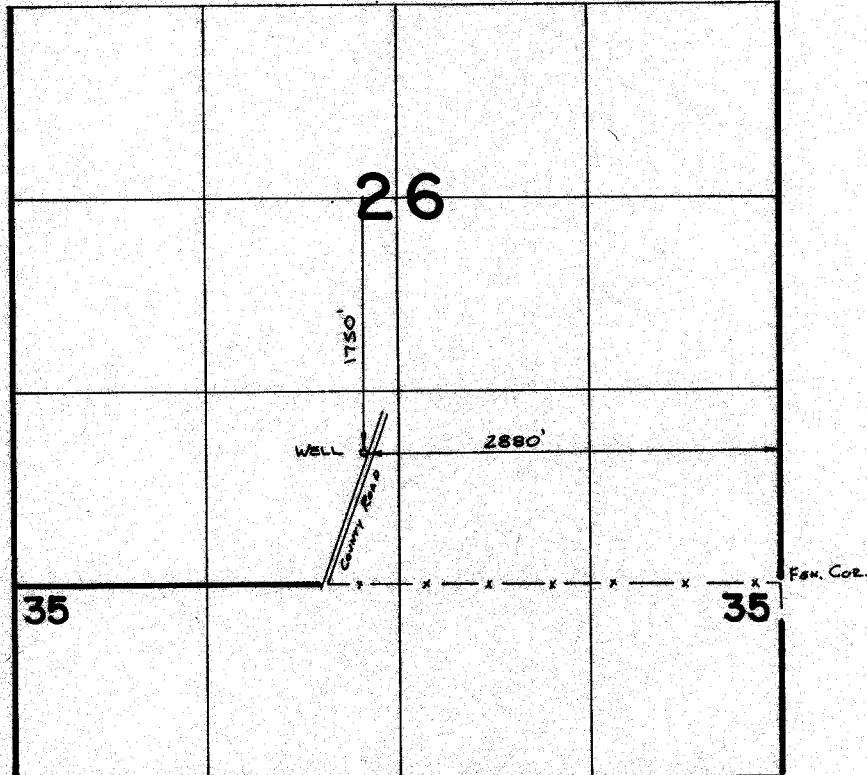

SCALE 1"=1320'

FINAL PROOF SURVEY
UNDER

Application No. **G:8251**. Permit No. **G:7609**..
IN NAME OF

CITY OF PRAIRIE CITY

Surveyed **3-17**..... 19**86**., by **J. Tell**.....

INSPECTION
PTS-1986-VA

VLC