
67653

T.31S.R. 8 E.W.M.

Application No. G 8378

Permit No. G 7771

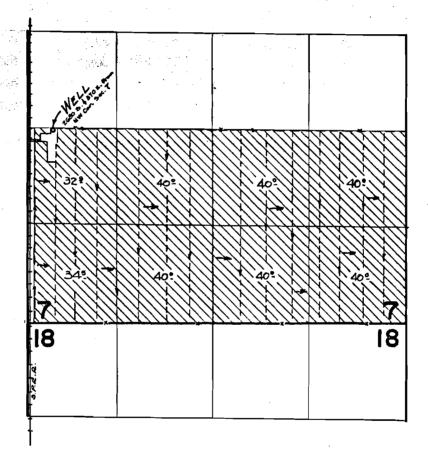

FINAL PROOF SURVEY

Application No. 6-2328 Permit No. 6-2152-IN NAME OF

E. MILES MAYFIELD

Surveyed May 23 1964, by Atheleson