


T. 18S., R. 41E., W.M.


 SCALE 1"=1320'

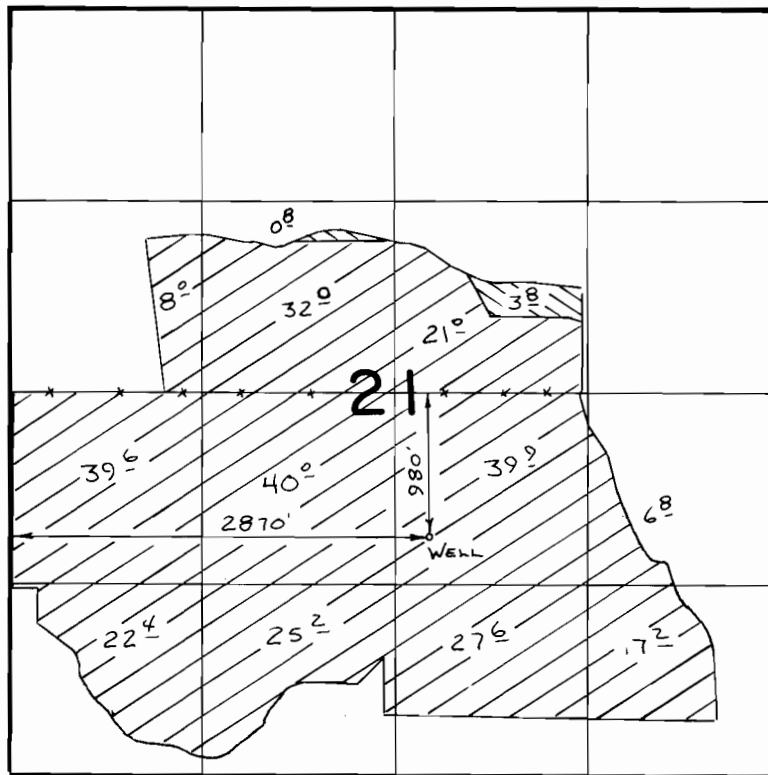

PRIM



SUPPL

FINAL PROOF SURVEY UNDER

Application No. **G:8542** Permit No. **G:8159**....
IN NAME OF

.....**SHROYER**.....**RANCH**.....

Surveyed **7-21**..... 19**88**., by **L.H. Church**.....