



T. 18S., R. 41E., W.M.

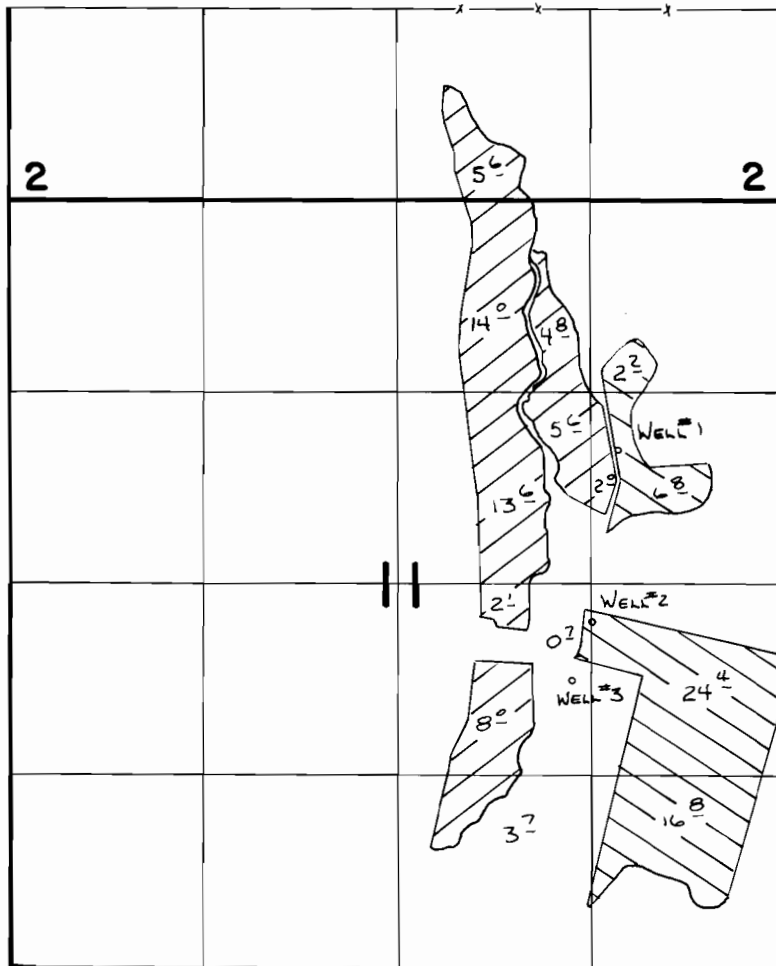

WELL #1 Loc: 920' N. & 1510' E.
 WELL #2 Loc: 260' S. & 1320' E.
 WELL #3 Loc: 660' S. & 1190' E. } FROM CENTER 1/4 COR. SEC. 11

FINAL PROOF SURVEY UNDER

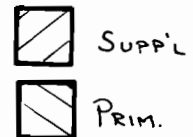

Application No. **G-8555** Permit No. **G-7918**
 IN NAME OF

TOM SILVEY

Surveyed 4-21 1988, by V.L. Church