


T. 22S., R. 32 1/2E., W.M.

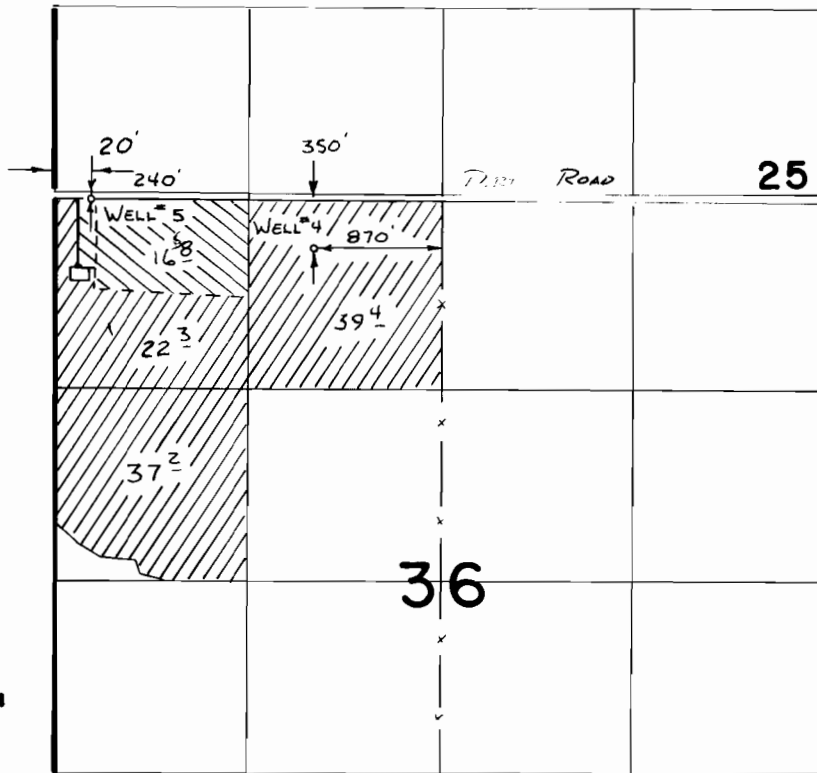

SCALE 1" = 1320'



PRIM.



SUPP'L

FINAL PROOF SURVEY
UNDER

Application No. **G:8573** Permit No. **G:7920**
IN NAME OF

LITTLE COW CREEK

Surveyed **5-6** 19**88**, by **D. SALEH**