


T.36S.,R.12E.,W.M.

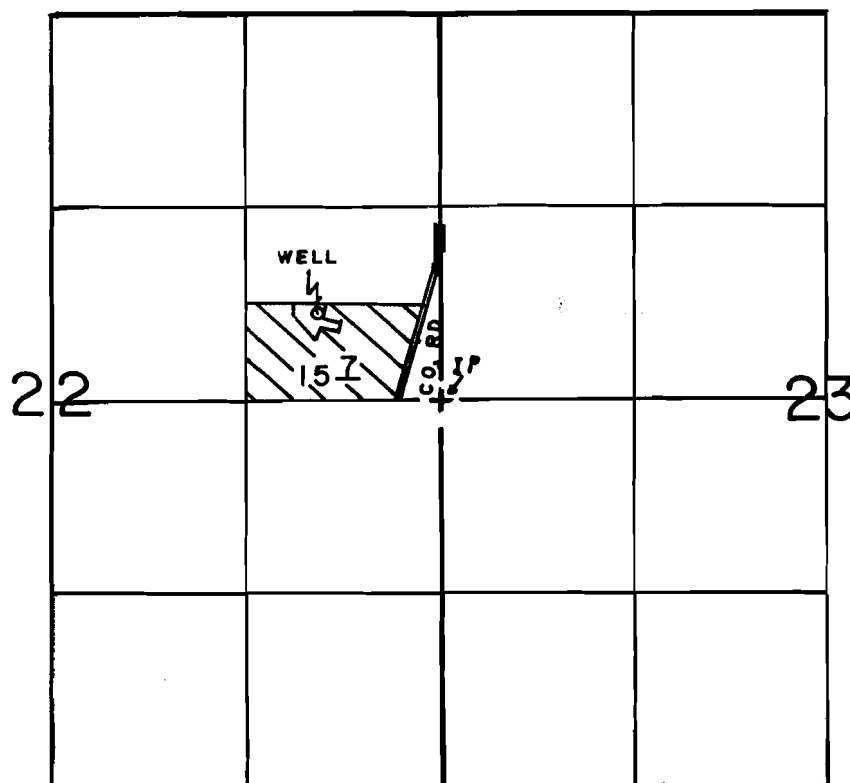

WELL LOC.: 600' N. & 850' W. FROM E 1/4 COR. OF SEC. 22.

SCALE: 1" = 1320'

FINAL PROOF SURVEY
UNDER

Application No. G-8693 Permit No. G-8124.....
IN NAME OF

CECIL R. OR MILDRED K. SOMMERS

Surveyed APR. 30 1991, by B.W. BISHOP..

Spring River Wells