


G-8623
67659

T. 41 S., R. 10 E., W. M.

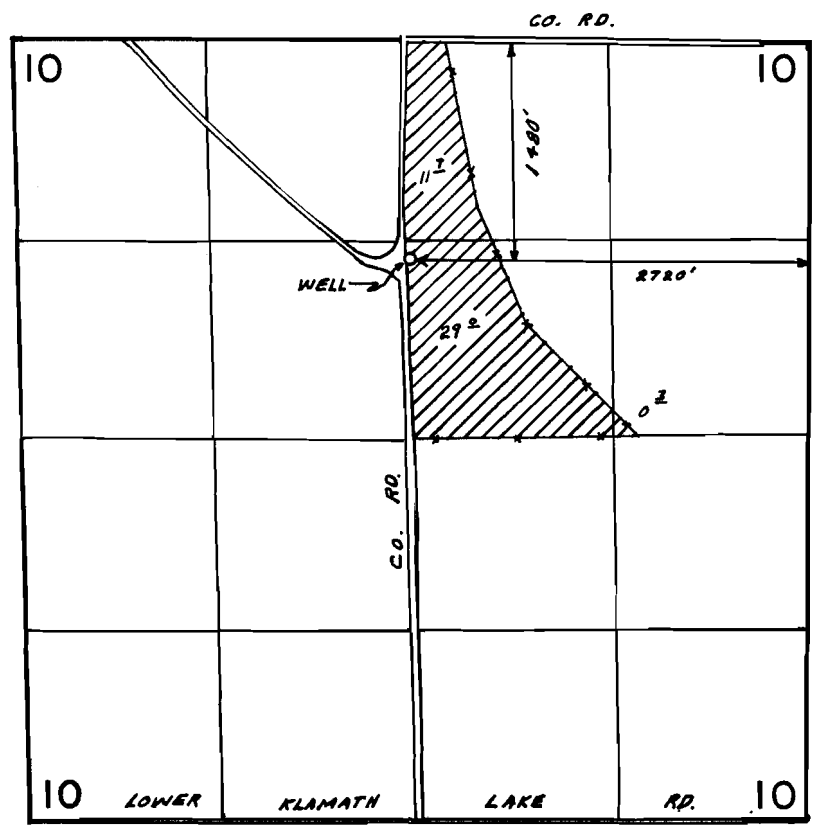

East River Wells

SCALE: 1"=1320'

FINAL PROOF SURVEY UNDER

Application No. G-9200 Permit No. G-8623.....
IN NAME OF

RALPH W. STEARNS

Surveyed OCT. 15, 1988, by B. BISHOP.....

1-31-89
d.s.c.