
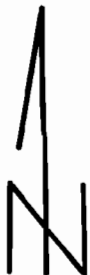


T. 25S., R. 33E., W.M.

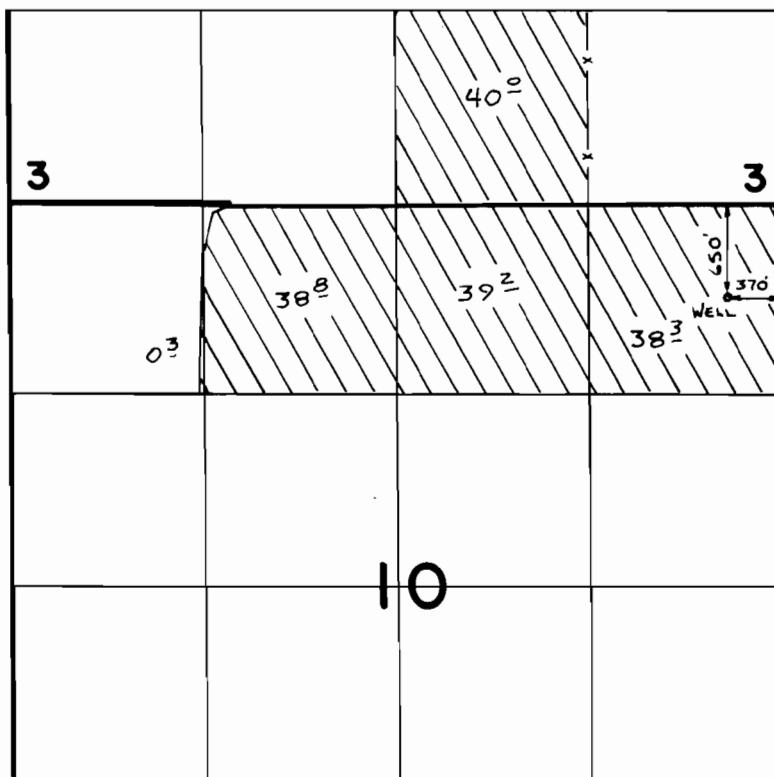

SCALE 1"=1320'

FINAL PROOF SURVEY
UNDER

Application No. **G-9376** Permit No. **G-8704**
IN NAME OF

RICHARD O. ADAMS

Surveyed **5-10** 19**88**, by **V.L. Church**